

UNITED STATES
DEPARTMENT OF THE INTERIOR
BUREAU OF LAND MANAGEMENT

SECTION


SE 1 NE 4

SEC. 28

Oregon State Water Filings

TOWNSHIP 37 S, RANGE 32 1/2 E, W. M.

North

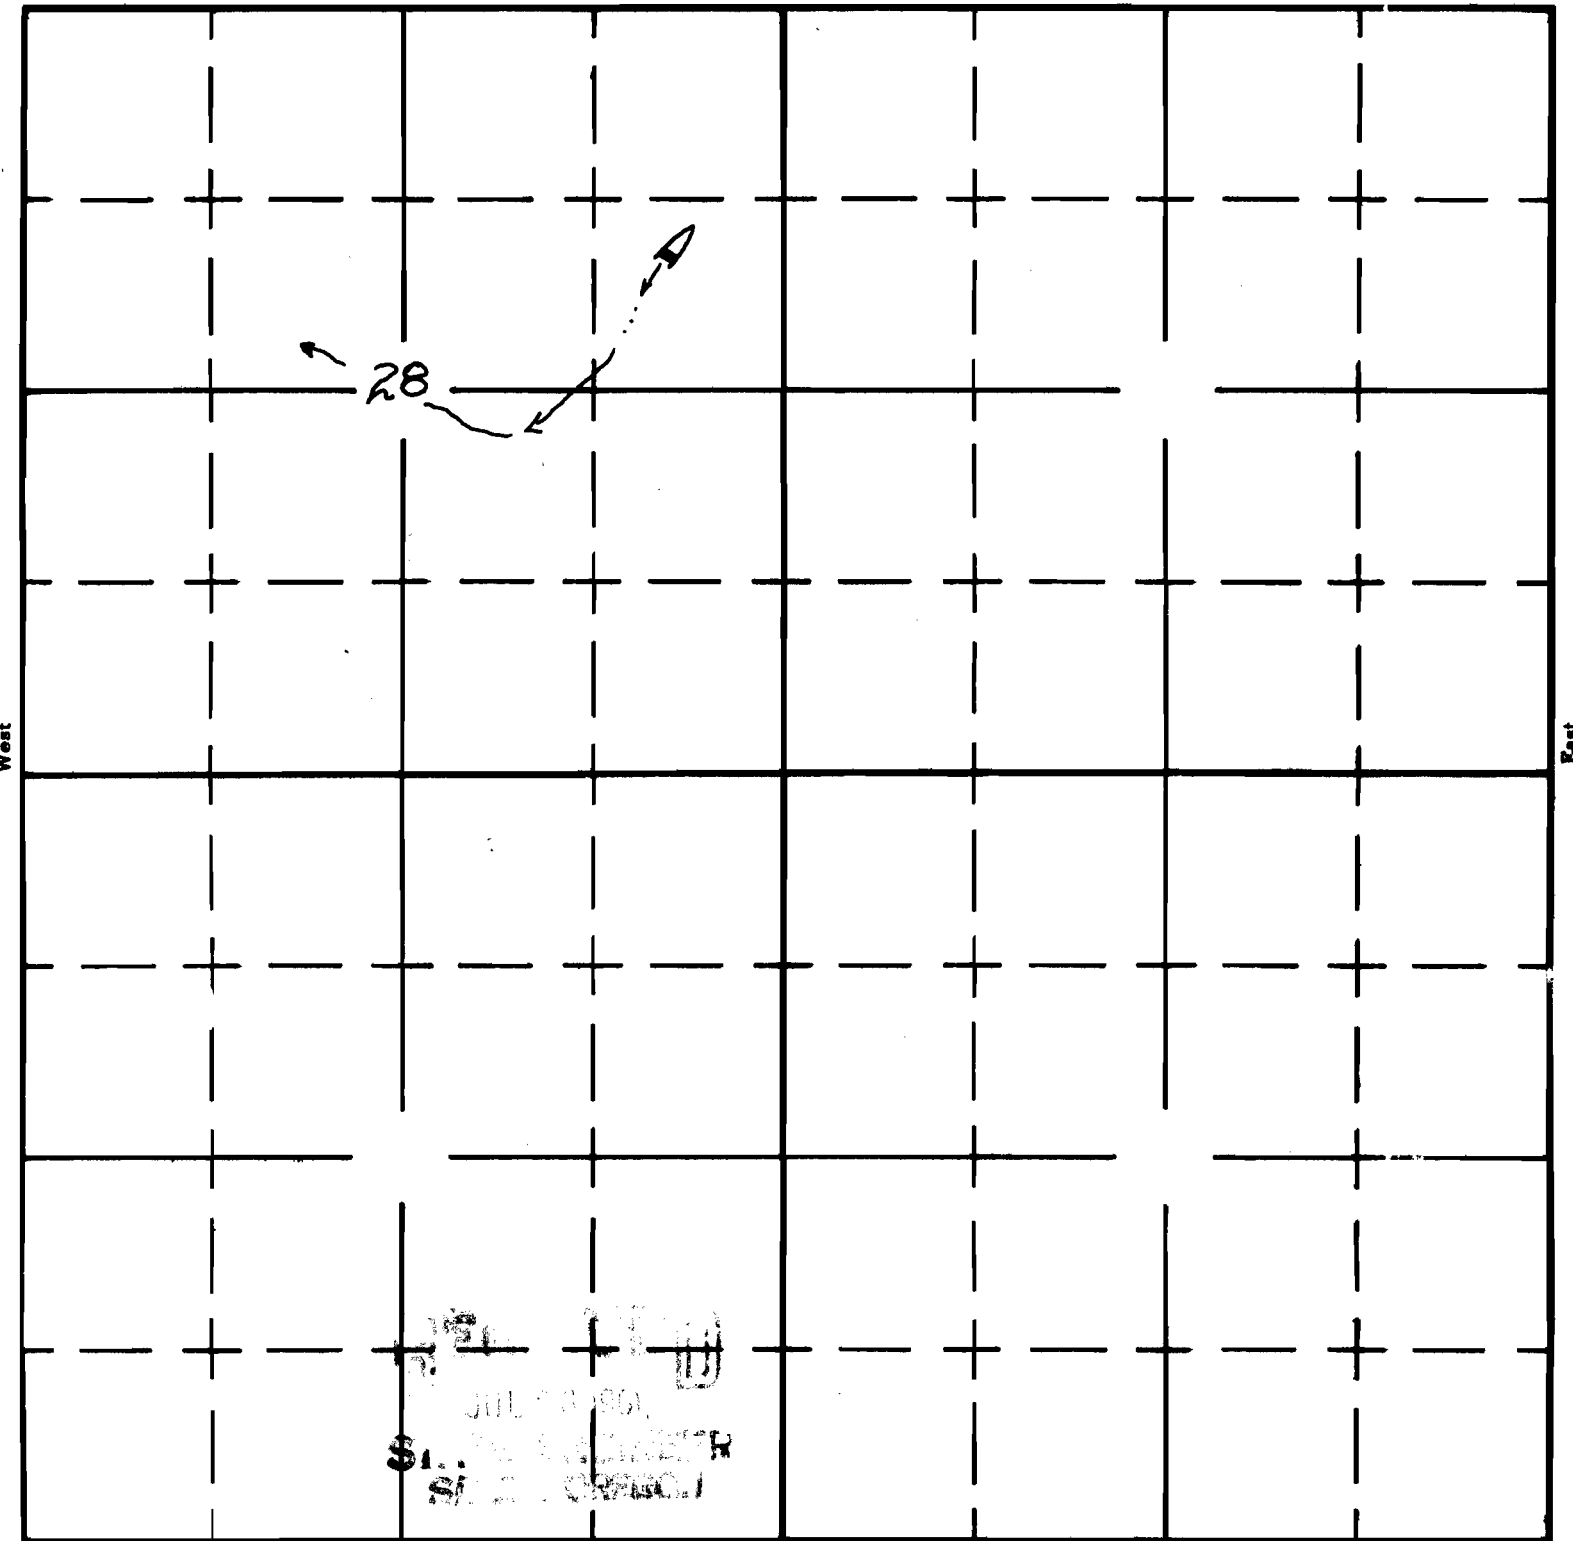

South

APPLICATION No. R-35553

PERMIT No. R-2896