

Form AI-187
March 1961

UNITED STATES
DEPARTMENT OF THE INTERIOR
BUREAU OF LAND MANAGEMENT

SECTION


NE $\frac{1}{4}$ NE $\frac{1}{4}$

Oregon State Water Filings

TOWNSHIP 38 S, RANGE 33 E, W. M.

SEC 20

North

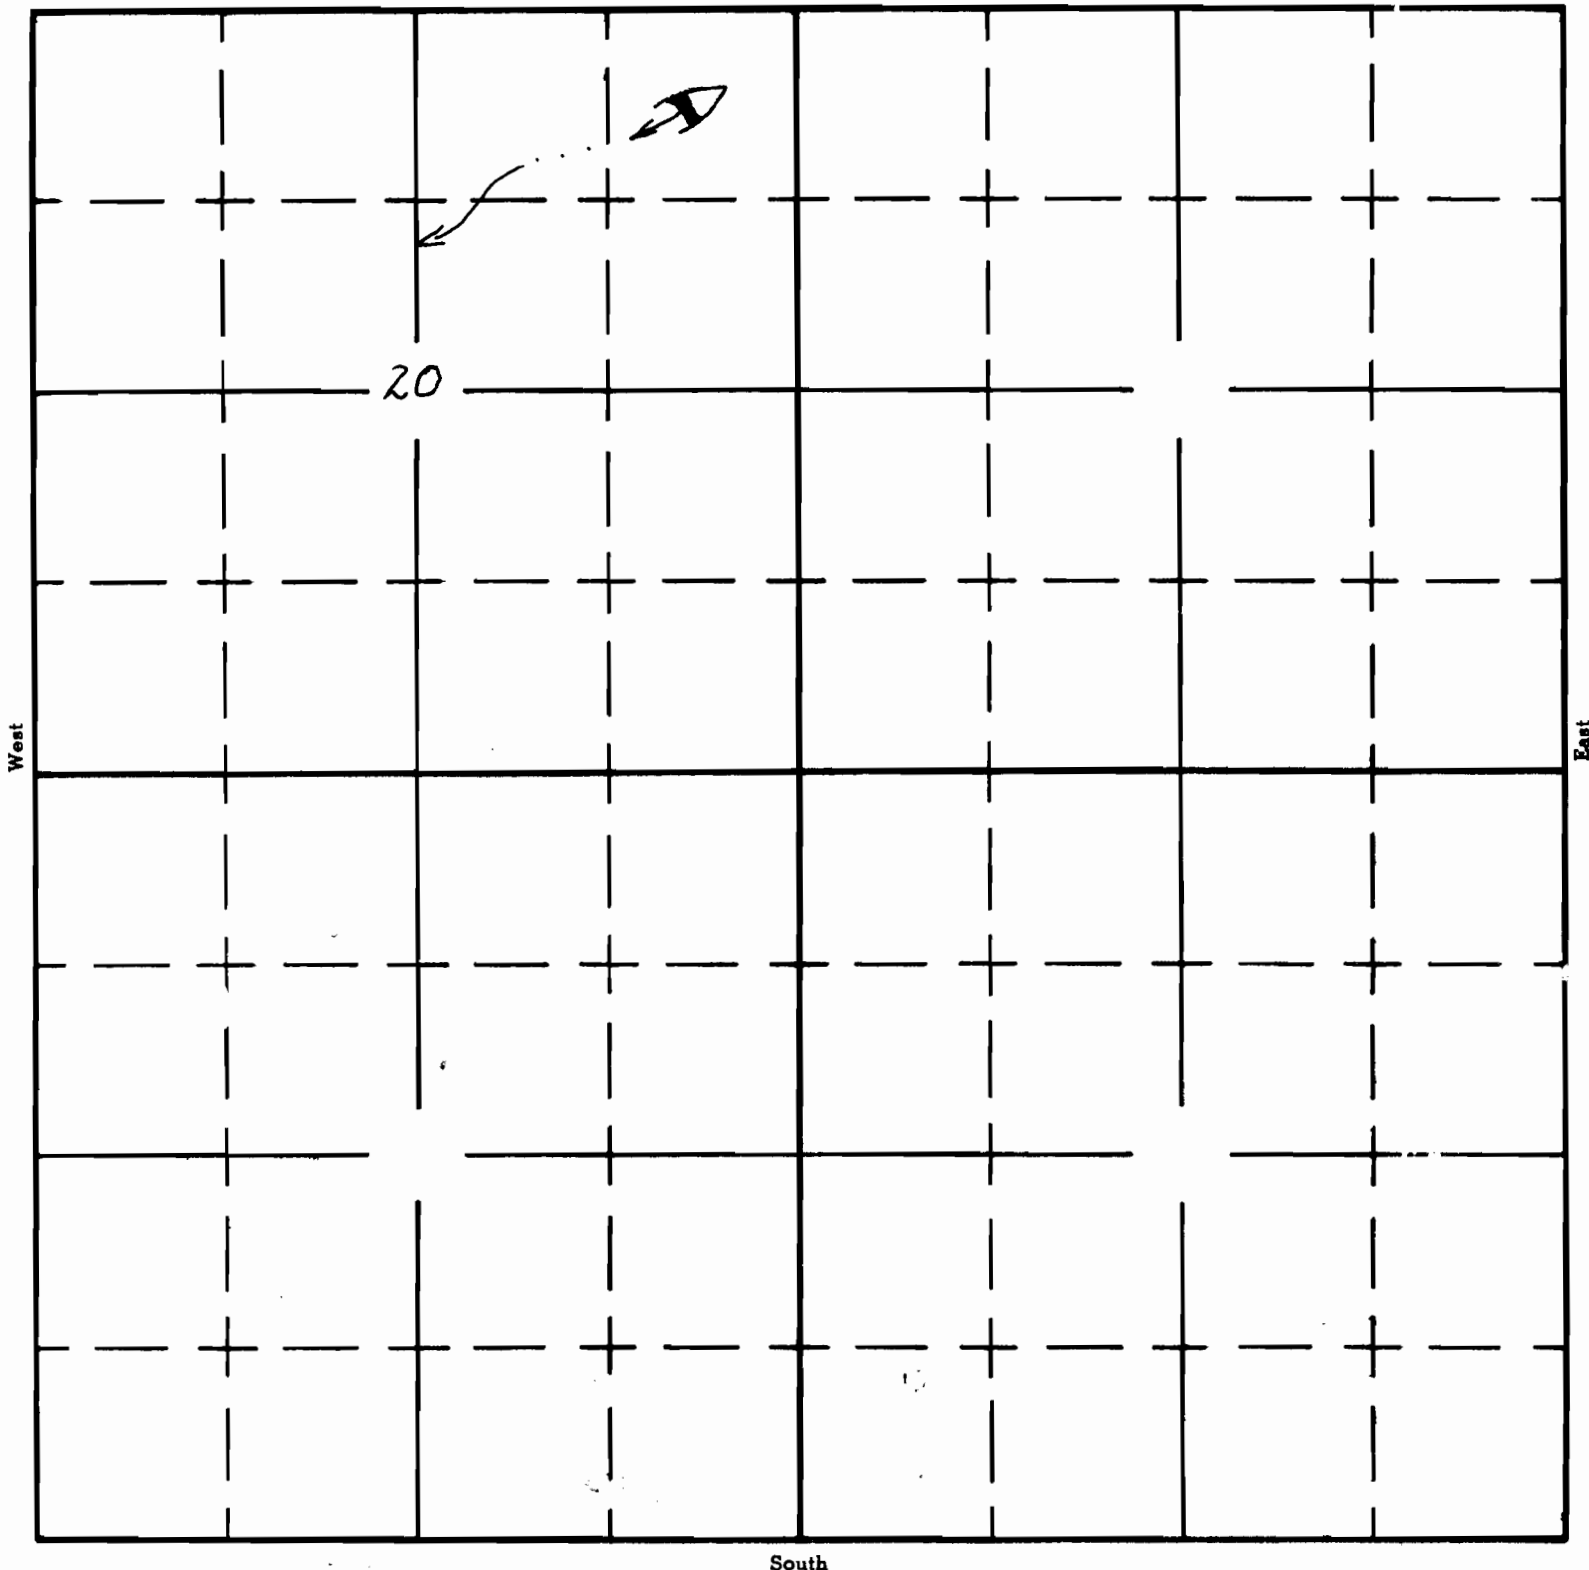

South

APPLICATION No. R-35556
PERMIT No. R-2899