

Form A1-187
March 1961

UNITED STATES
DEPARTMENT OF THE INTERIOR
BUREAU OF LAND MANAGEMENT

SECTION


NW¹/₄ NW¹/₄

Oregon State Water Filings

SEC. 31

TOWNSHIP 38 S, RANGE 33 E, W. M.

North

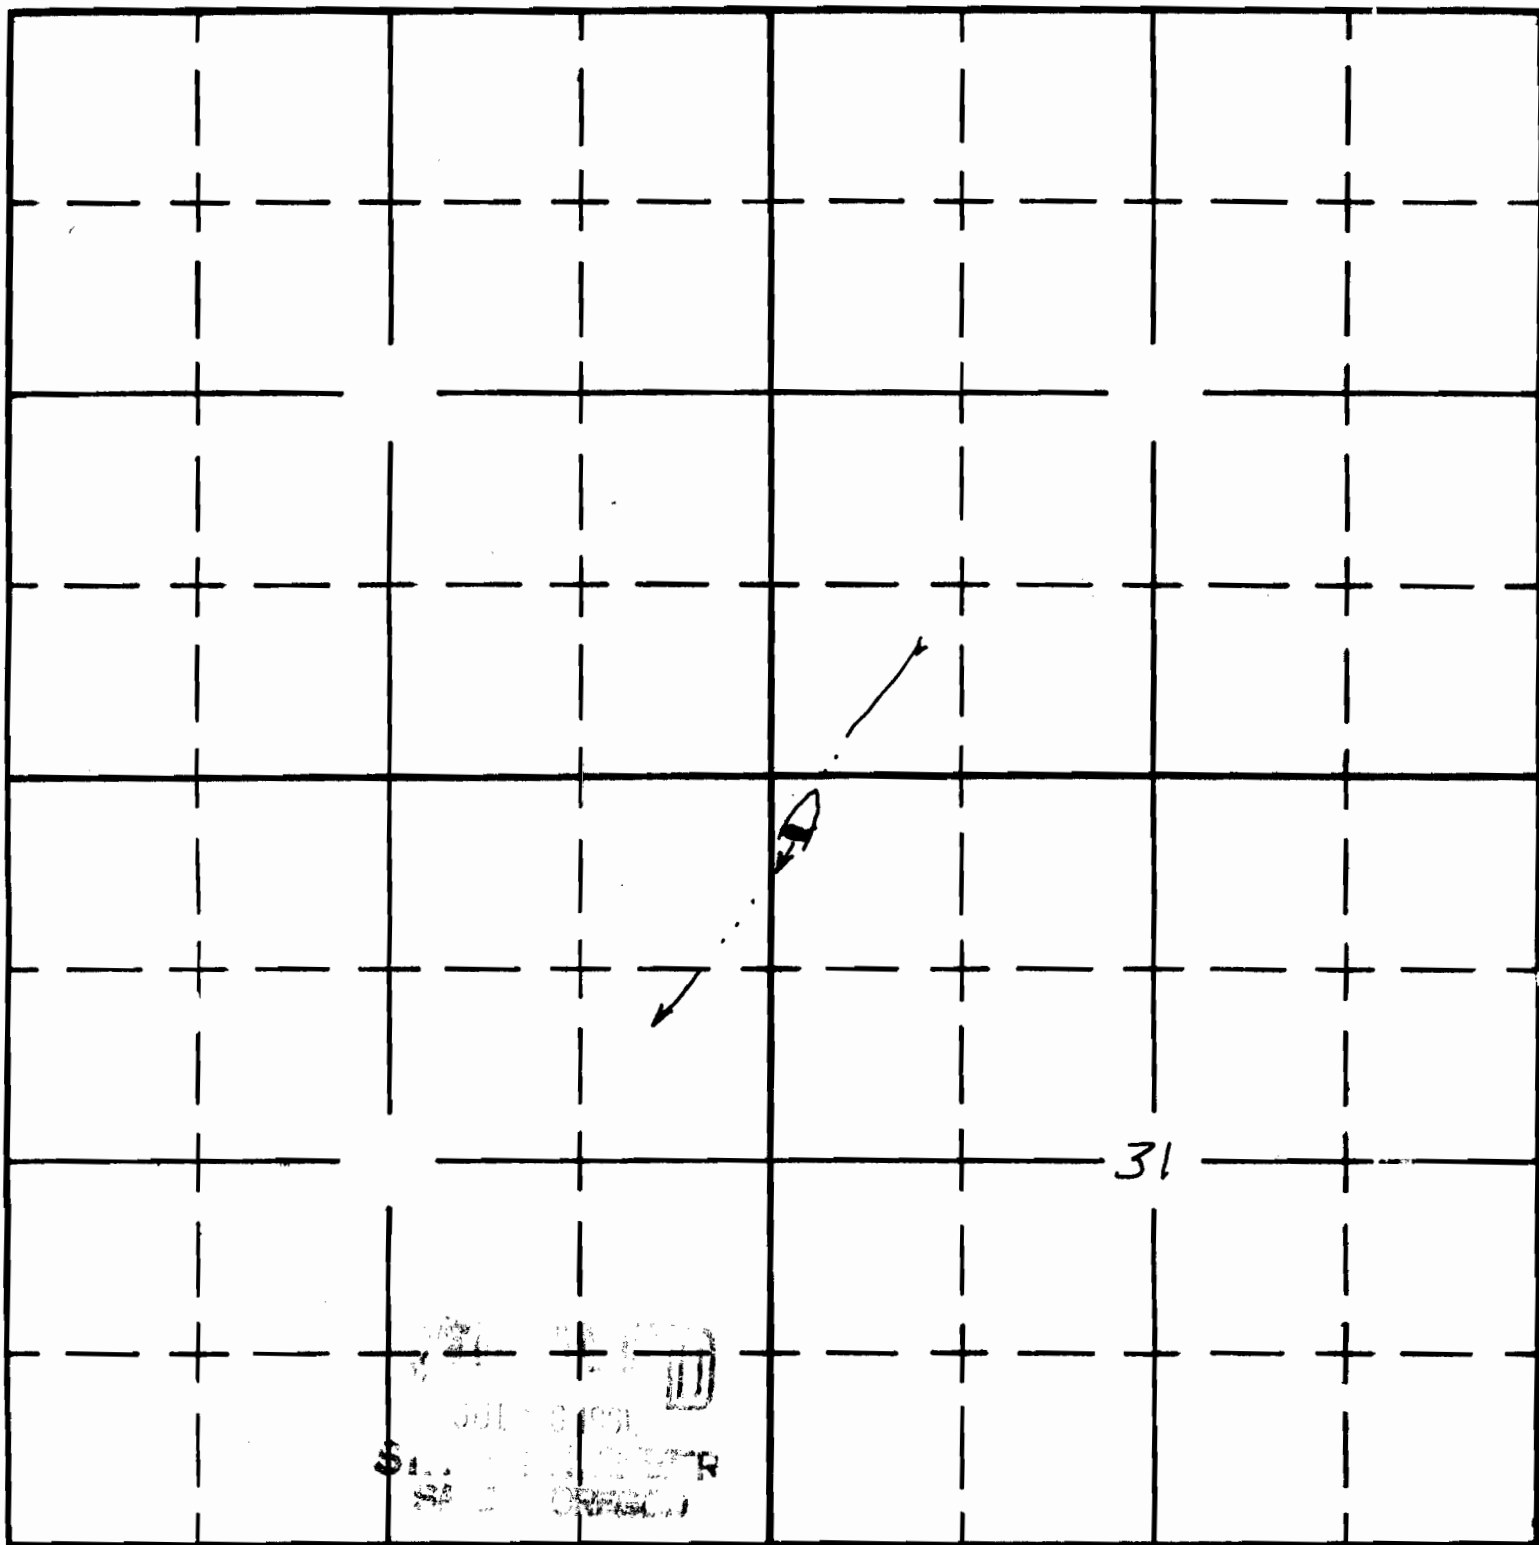

South

APPLICATION No. R-35557

PERMIT No. R-2900