

UNITED STATES
DEPARTMENT OF THE INTERIOR
BUREAU OF LAND MANAGEMENT

SECTION


SW $\frac{1}{4}$ NW $\frac{1}{4}$

Sec 5

Oregon State Water Filings

TOWNSHIP 41S, RANGE 35E, W. M.

North

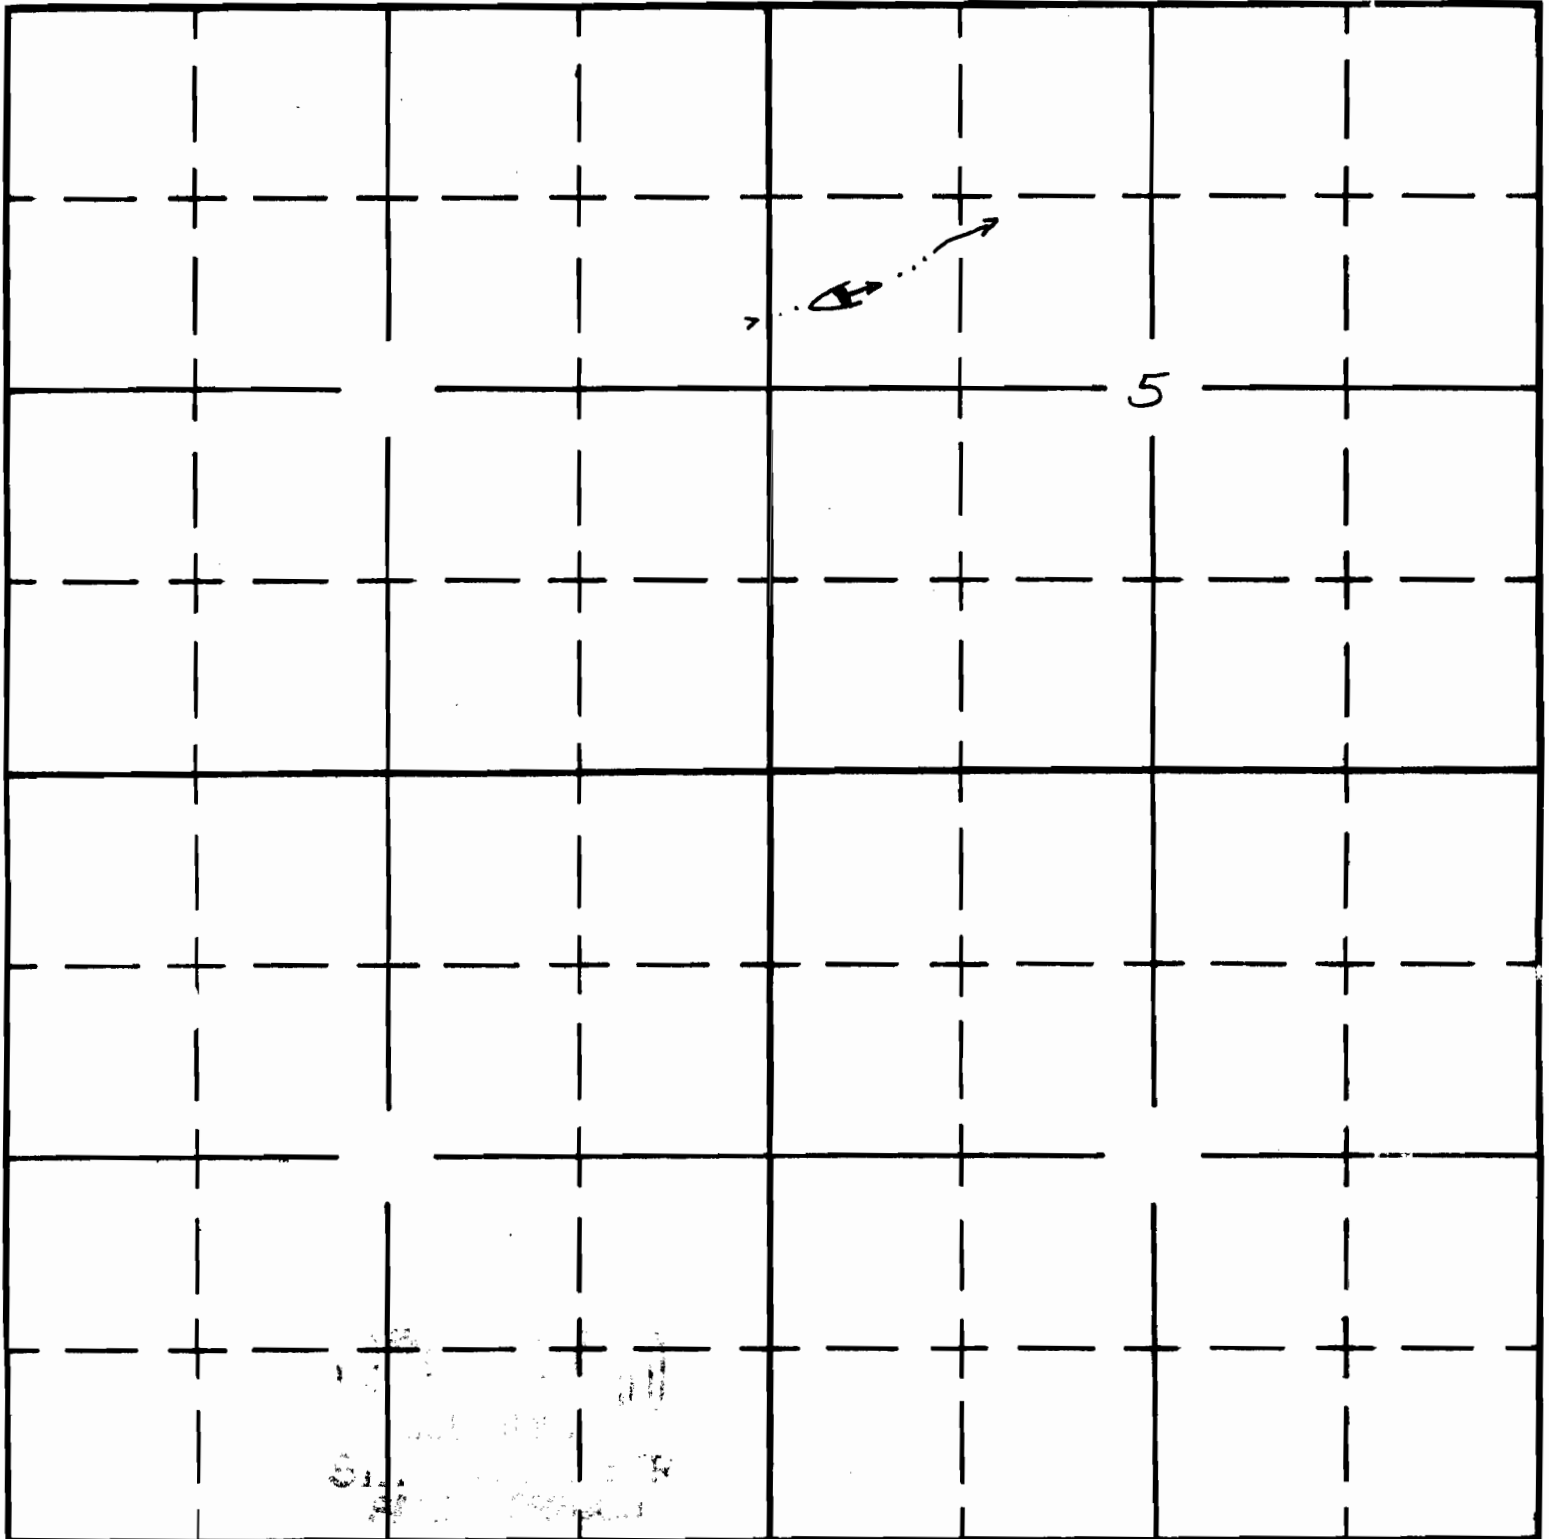

South

APPLICATION No. R-35558

PERMIT No. R-2901