


UNITED STATES
DEPARTMENT OF THE INTERIOR
BUREAU OF LAND MANAGEMENT

SECTION
NE 1/4 SW 1/4
SEC 21

Oregon State Water Filings

TOWNSHIP 33 S, RANGE 36 E, W. M.

North

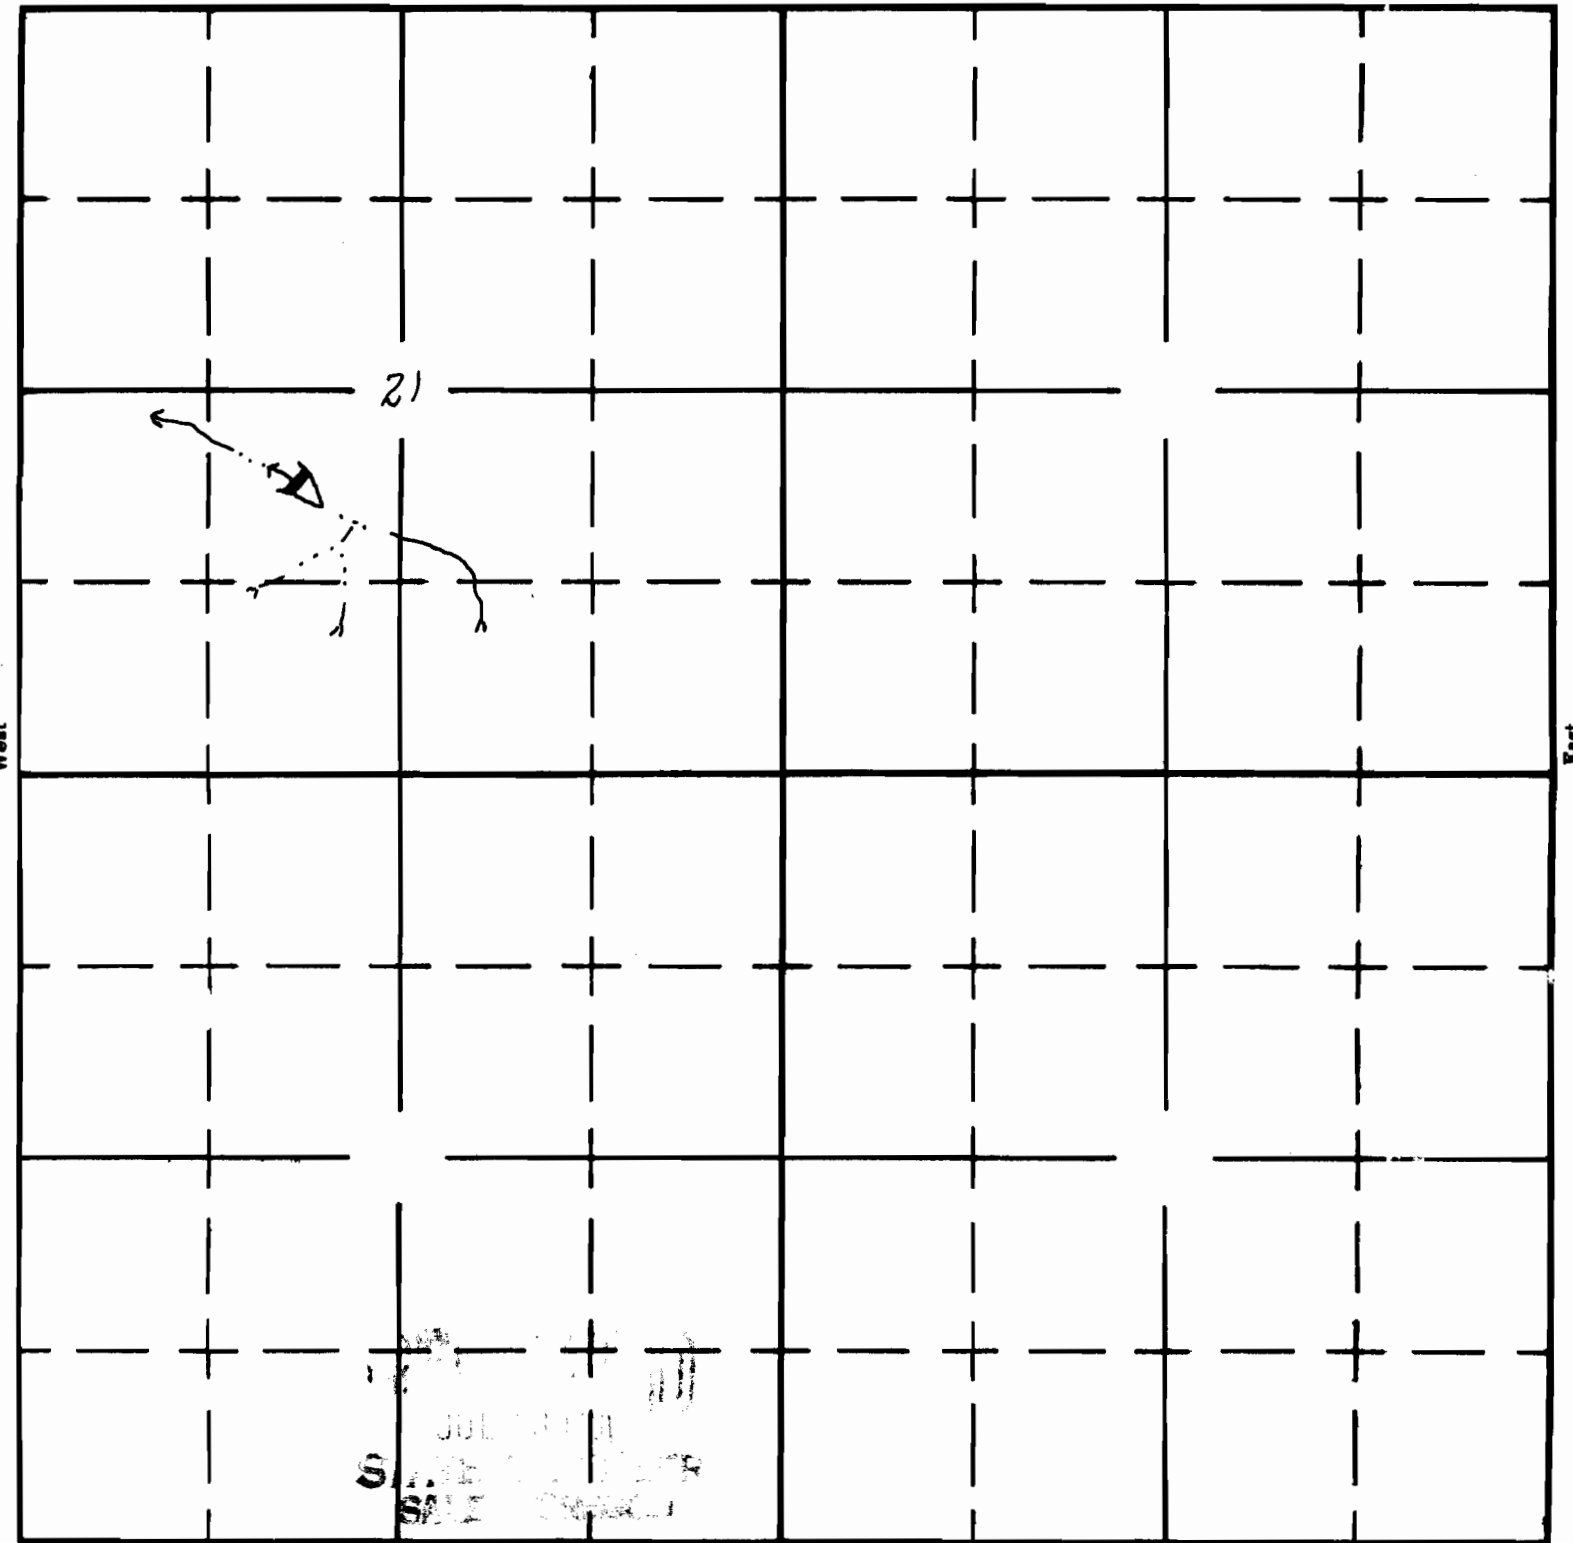

South

APPLICATION No. A-35560

PERMIT No. A-2903