

UNITED STATES
DEPARTMENT OF THE INTERIOR
BUREAU OF LAND MANAGEMENT

SECTION


NW $\frac{1}{4}$ NE $\frac{1}{4}$

SEC. 18

Oregon State Water Filings

TOWNSHIP 31S, RANGE 32E, W. M.

North

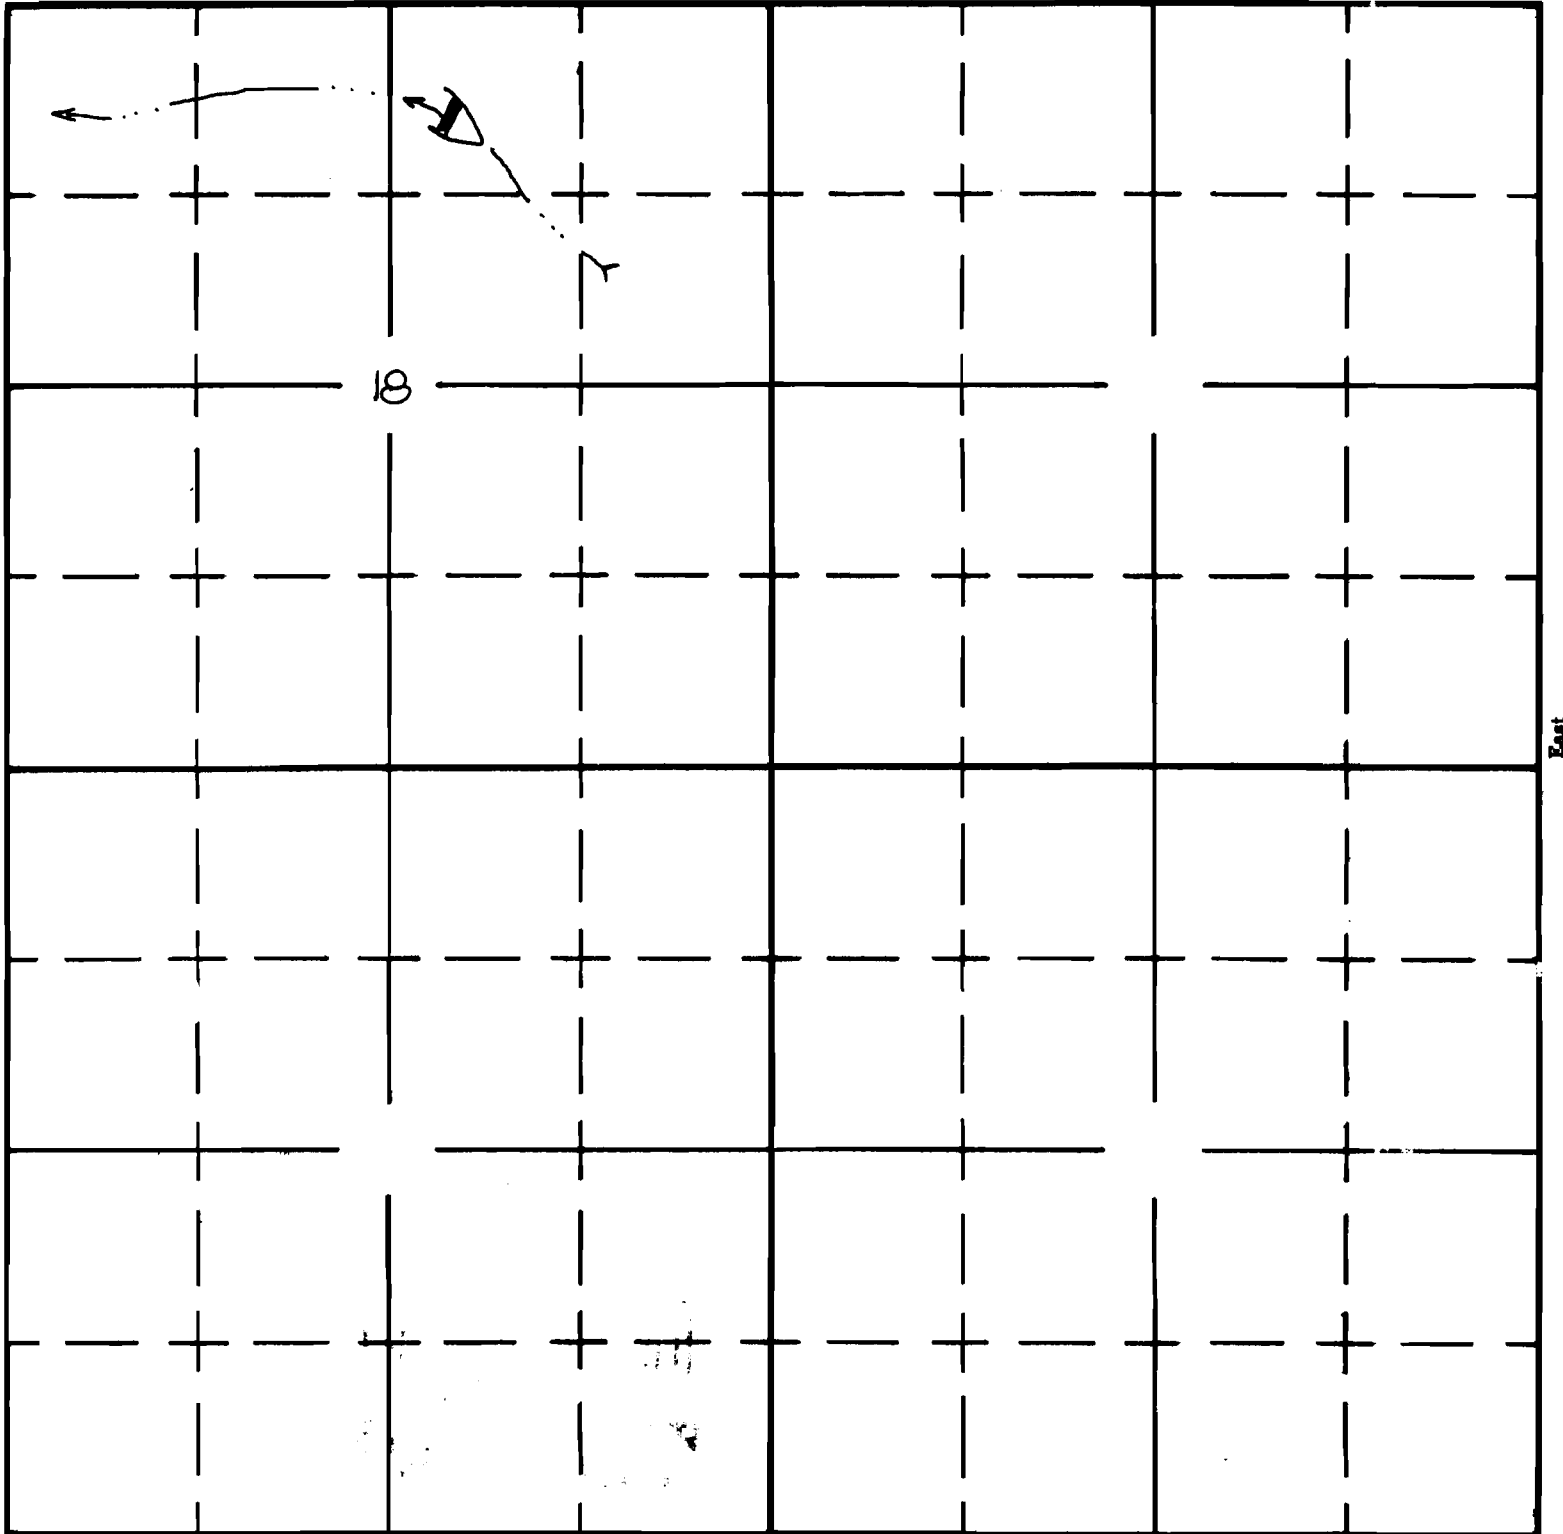

South

APPLICATION No. R-36573

PERMIT No. R-2914