

Form A1-187
March 1961

UNITED STATES
DEPARTMENT OF THE INTERIOR
BUREAU OF LAND MANAGEMENT

SECTION


NW 1/4 NE 1/4

Oregon State Water Filings

Sec 25

TOWNSHIP 31 S, RANGE 36 E, W. M.

North

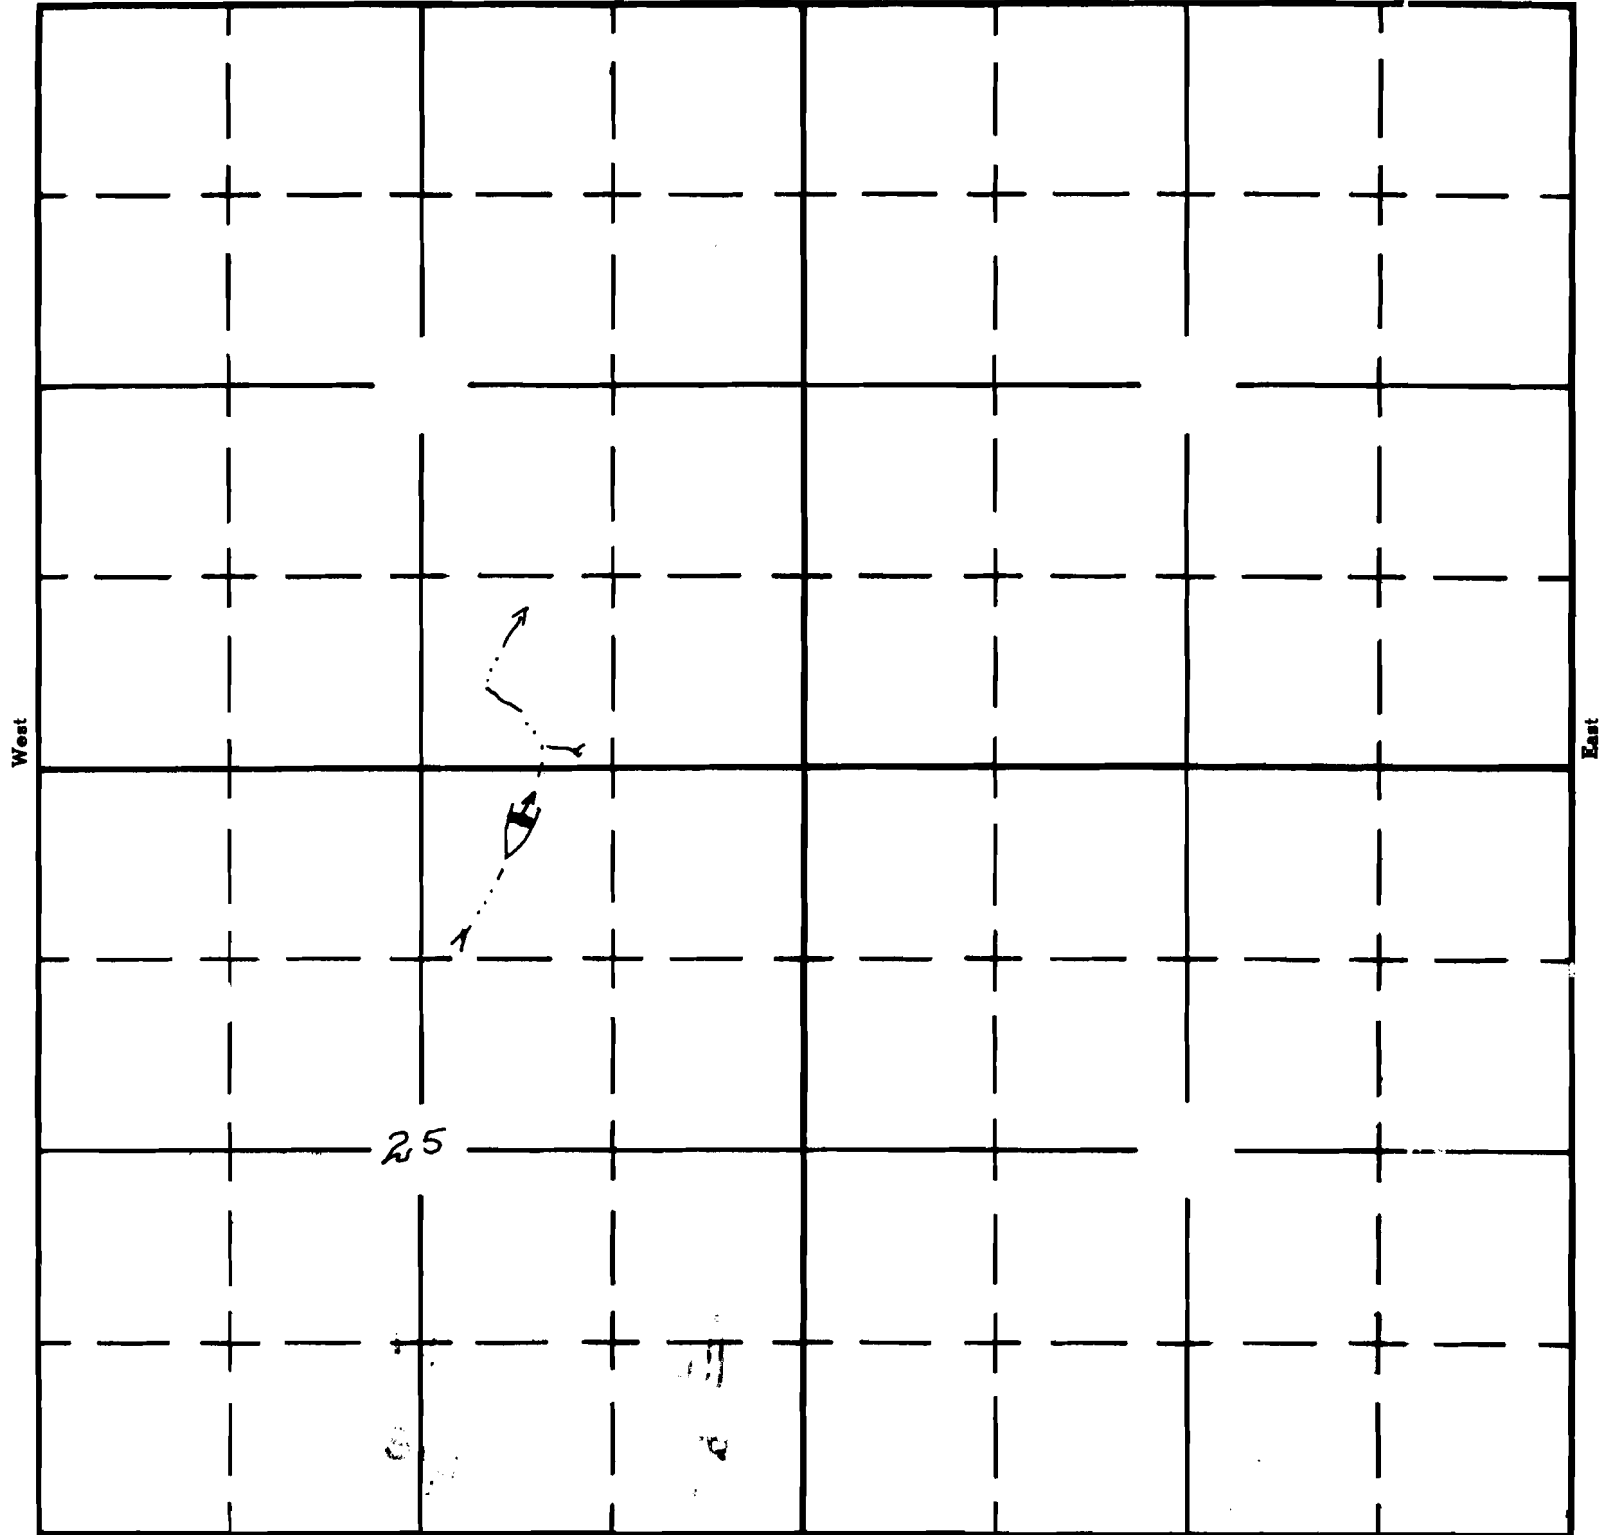

South

APPLICATION No. R-35583

PERMIT No. R-2727