

Form A1-187
March 1961

UNITED STATES
DEPARTMENT OF THE INTERIOR
BUREAU OF LAND MANAGEMENT


SECTION

NW¹/₄ NW¹/₄
SEC. 17

Oregon State Water Filings

TOWNSHIP 32 S, RANGE 32 ³/₄ E, W. M.

North

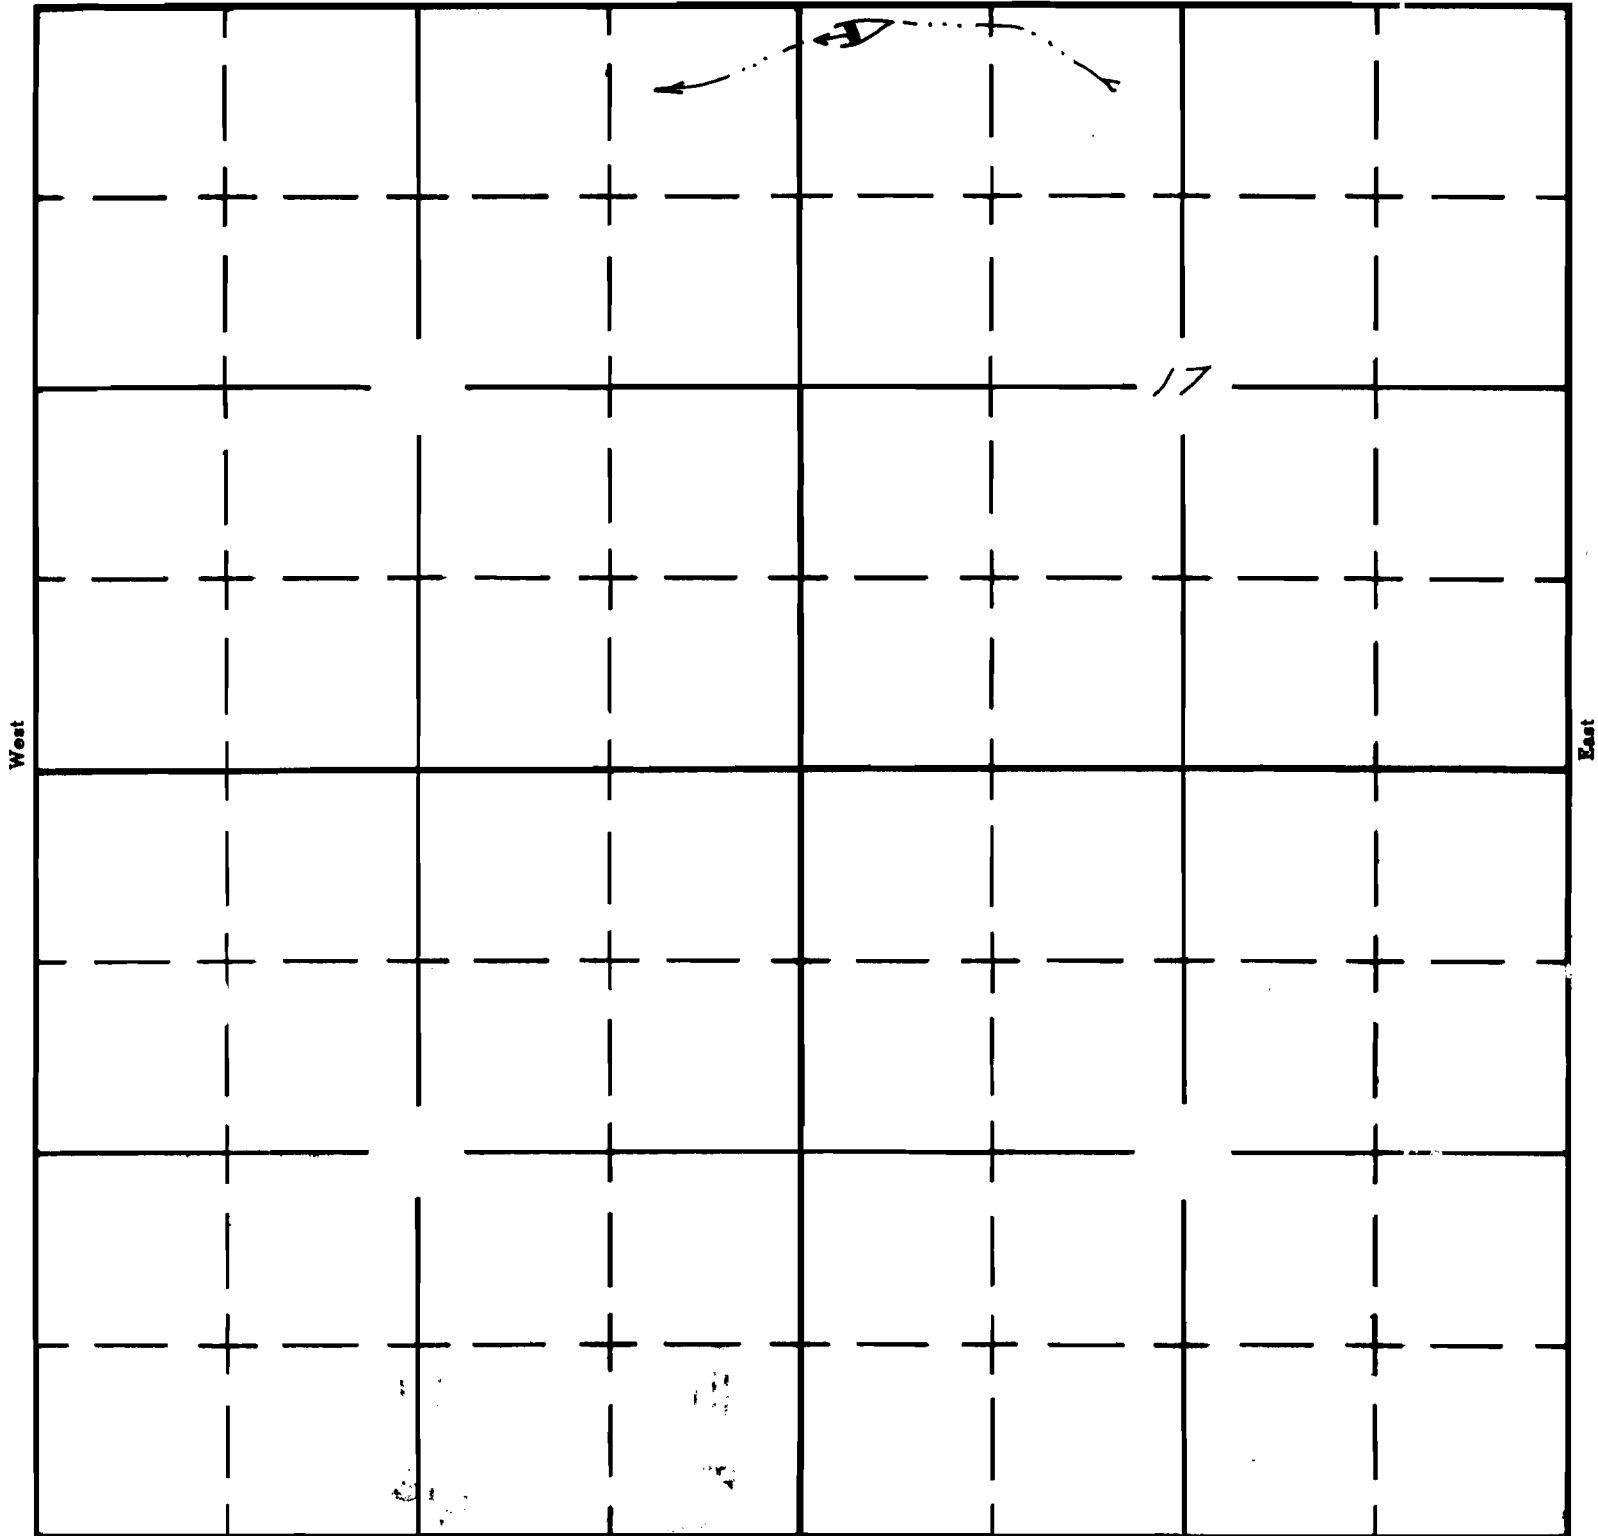

South

APPLICATION No. H-35590

PERMIT No. H-2981