

Form A1-187
March 1961

UNITED STATES
DEPARTMENT OF THE INTERIOR
BUREAU OF LAND MANAGEMENT

SECTION


SE $\frac{1}{4}$ SE $\frac{1}{4}$

Oregon State Water Filings

SEC 2

TOWNSHIP 40S, RANGE 36E, W. M.

North

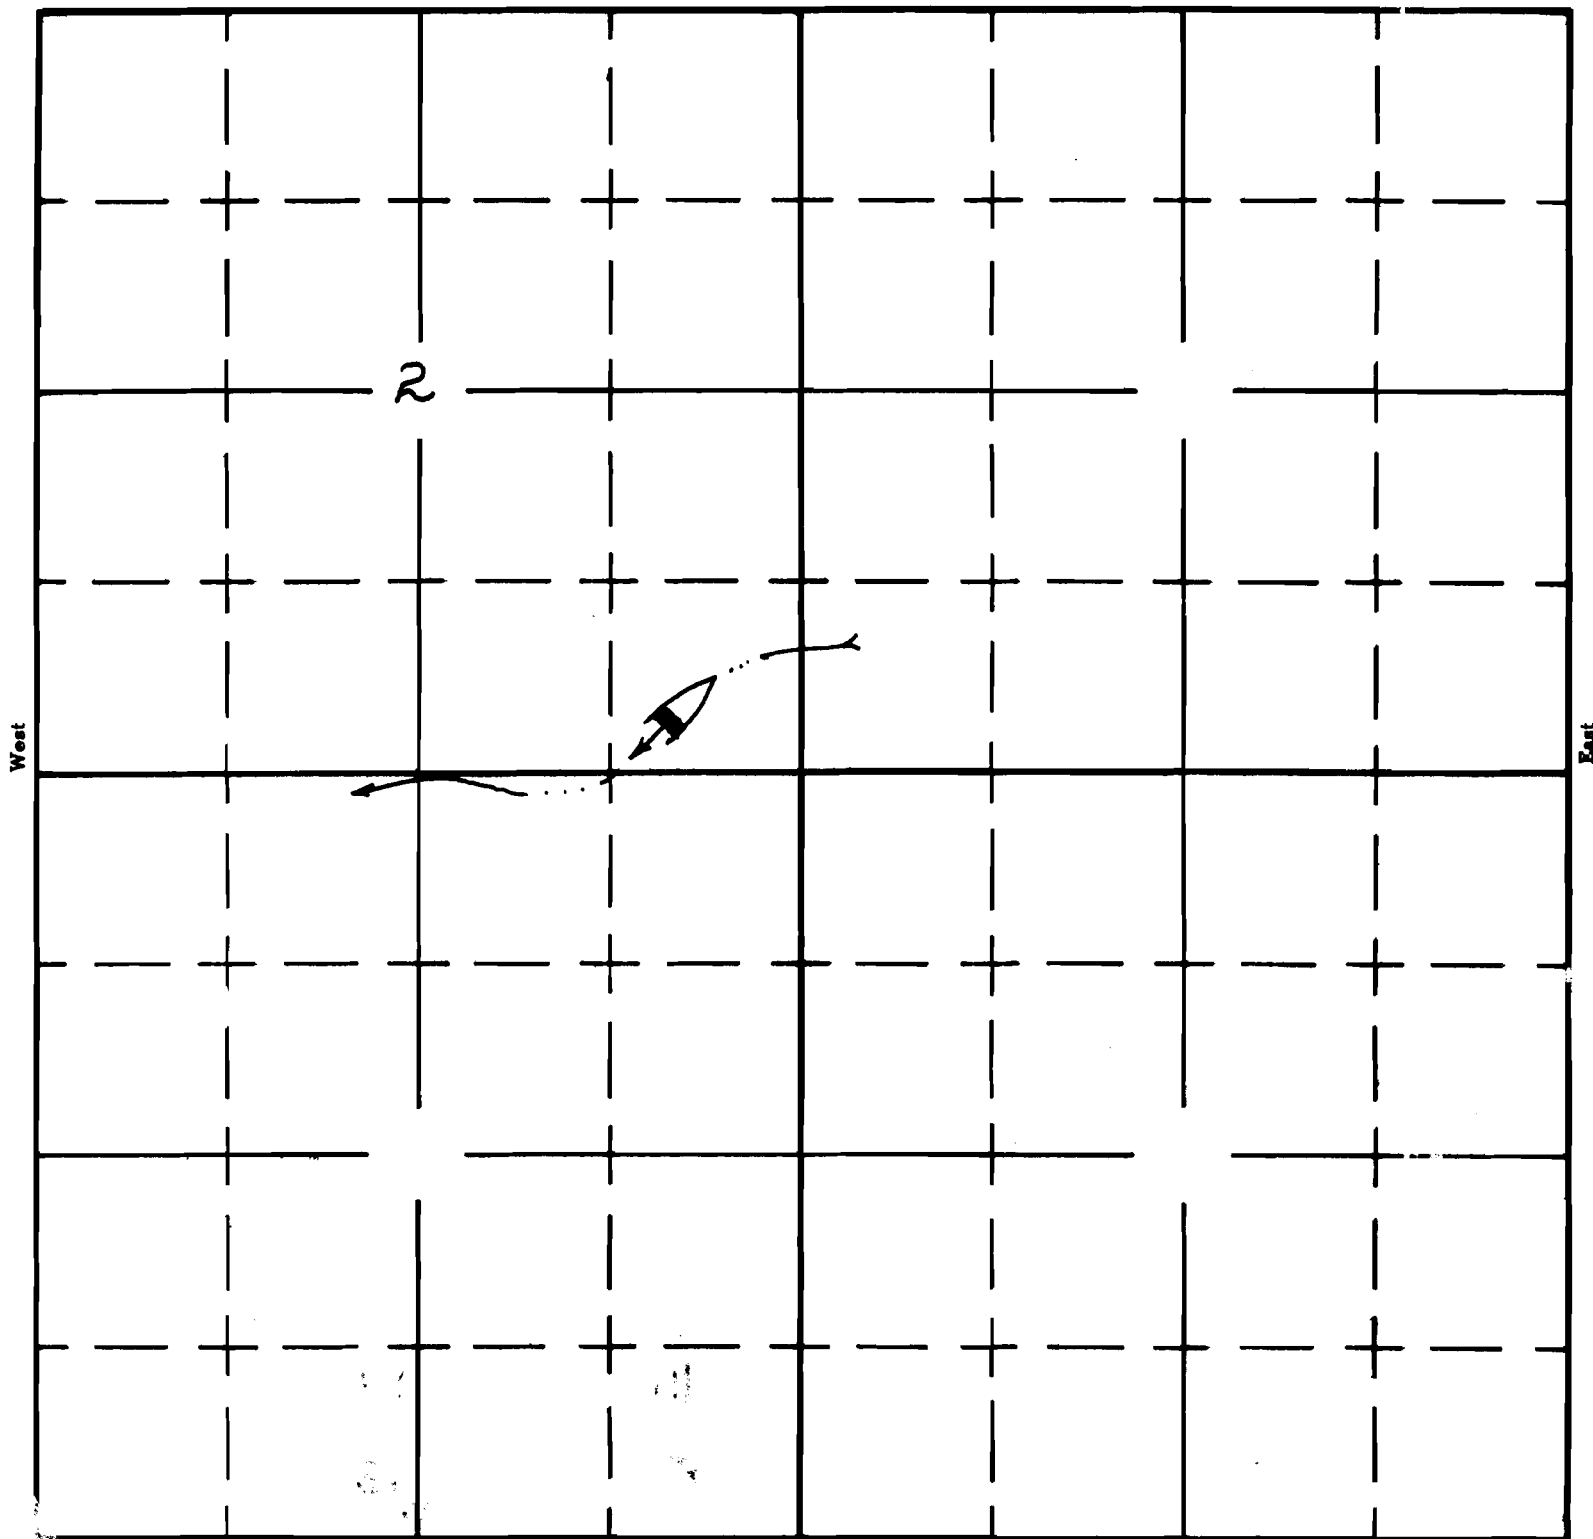

South

APPLICATION No. R-35897

PERMIT No. R-2438