

UNITED STATES
DEPARTMENT OF THE INTERIOR
BUREAU OF LAND MANAGEMENT

SECTION


NW $\frac{1}{4}$ SW $\frac{1}{4}$

Oregon State Water Filings

SEC 28

TOWNSHIP 31S, RANGE 32 $\frac{3}{4}$ E, W. M.

North

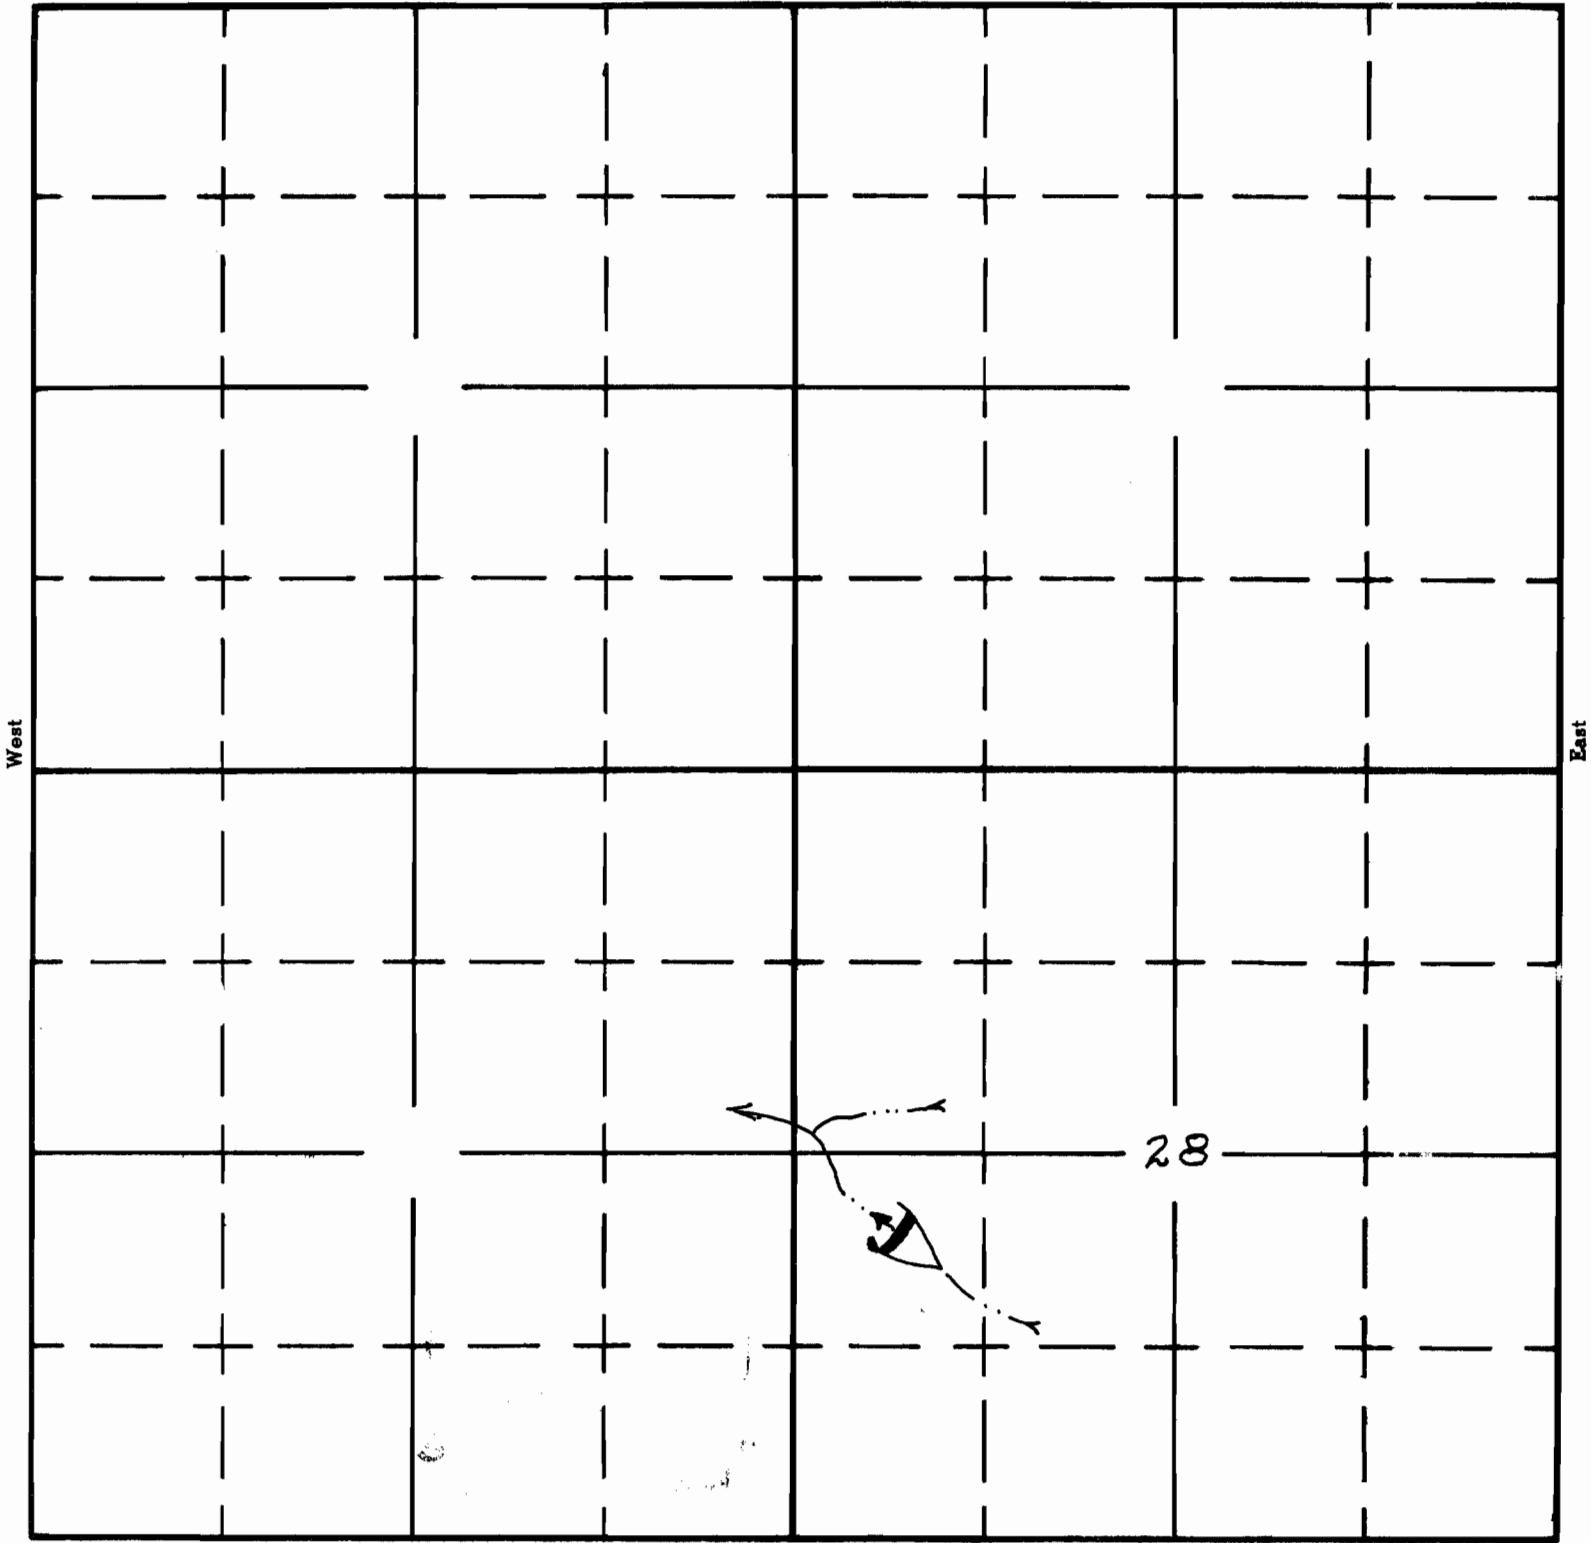

South

APPLICATION No. R-35341

PERMIT No. R-3103