

Form AI-187
March 1961

UNITED STATES
DEPARTMENT OF THE INTERIOR
BUREAU OF LAND MANAGEMENT

SECTION


NE 1/4 SW 1/4

Oregon State Water Filings

SEC. 35

TOWNSHIP 31 S, RANGE 36 E, W. M.

North

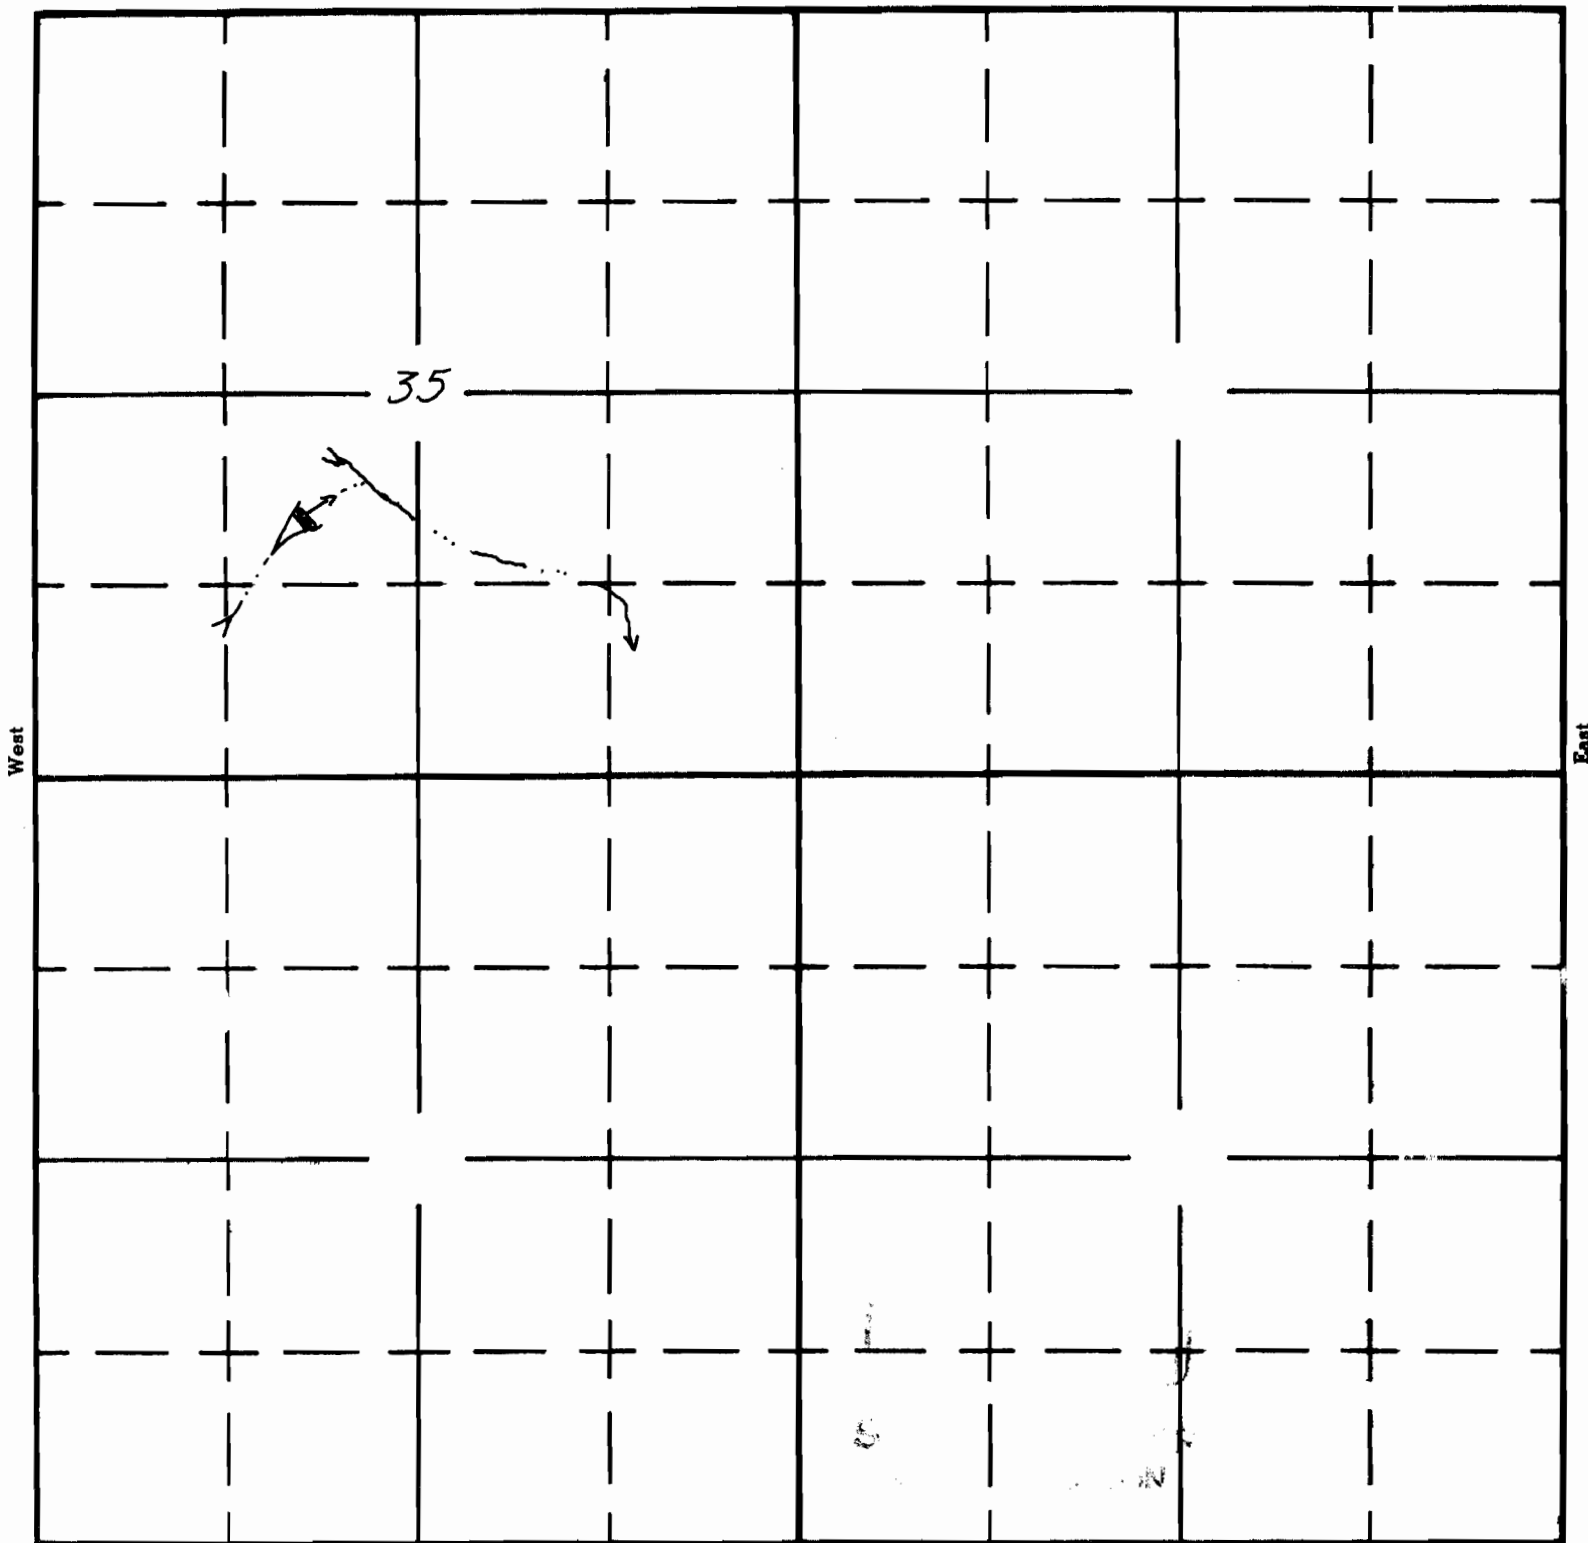

Unwatered
Pickup on of Almond Dam

APPLICATION No. R-35369
PERMIT No. R-3112