

UNITED STATES
DEPARTMENT OF THE INTERIOR
BUREAU OF LAND MANAGEMENT


SECTION

NW 1/4 SE 1/4 Oregon State Water Filings

6

TOWNSHIP 40S, RANGE 32E, W. M.

North

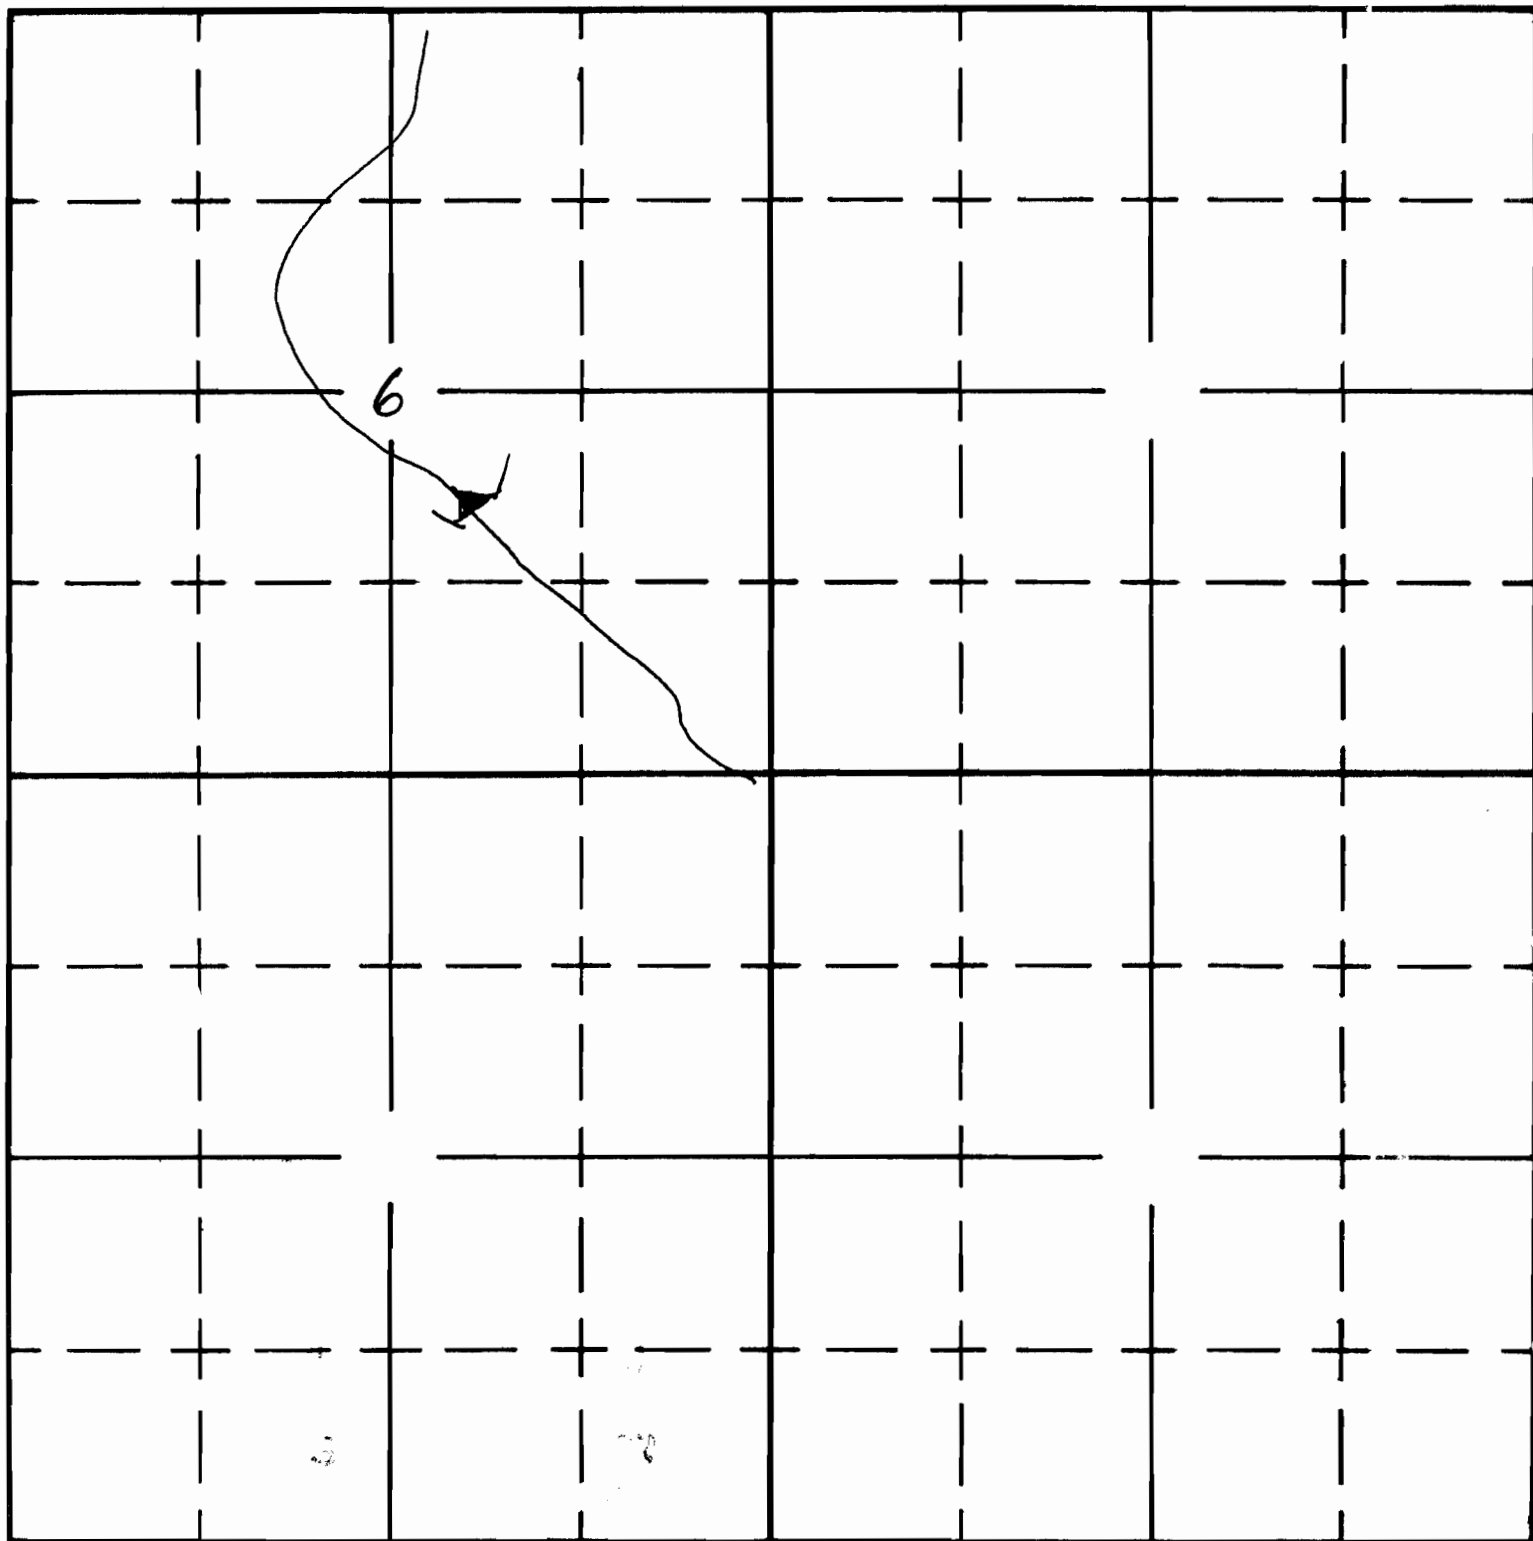

South

APPLICATION No. R-35411
PERMIT No. R-3299