

UNITED STATES
DEPARTMENT OF THE INTERIOR
BUREAU OF LAND MANAGEMENT

SECTION

NE 1/4 SW 1/4

Oregon State Water Filings


23

TOWNSHIP 22S, RANGE 27E, W. M.

North

West

East

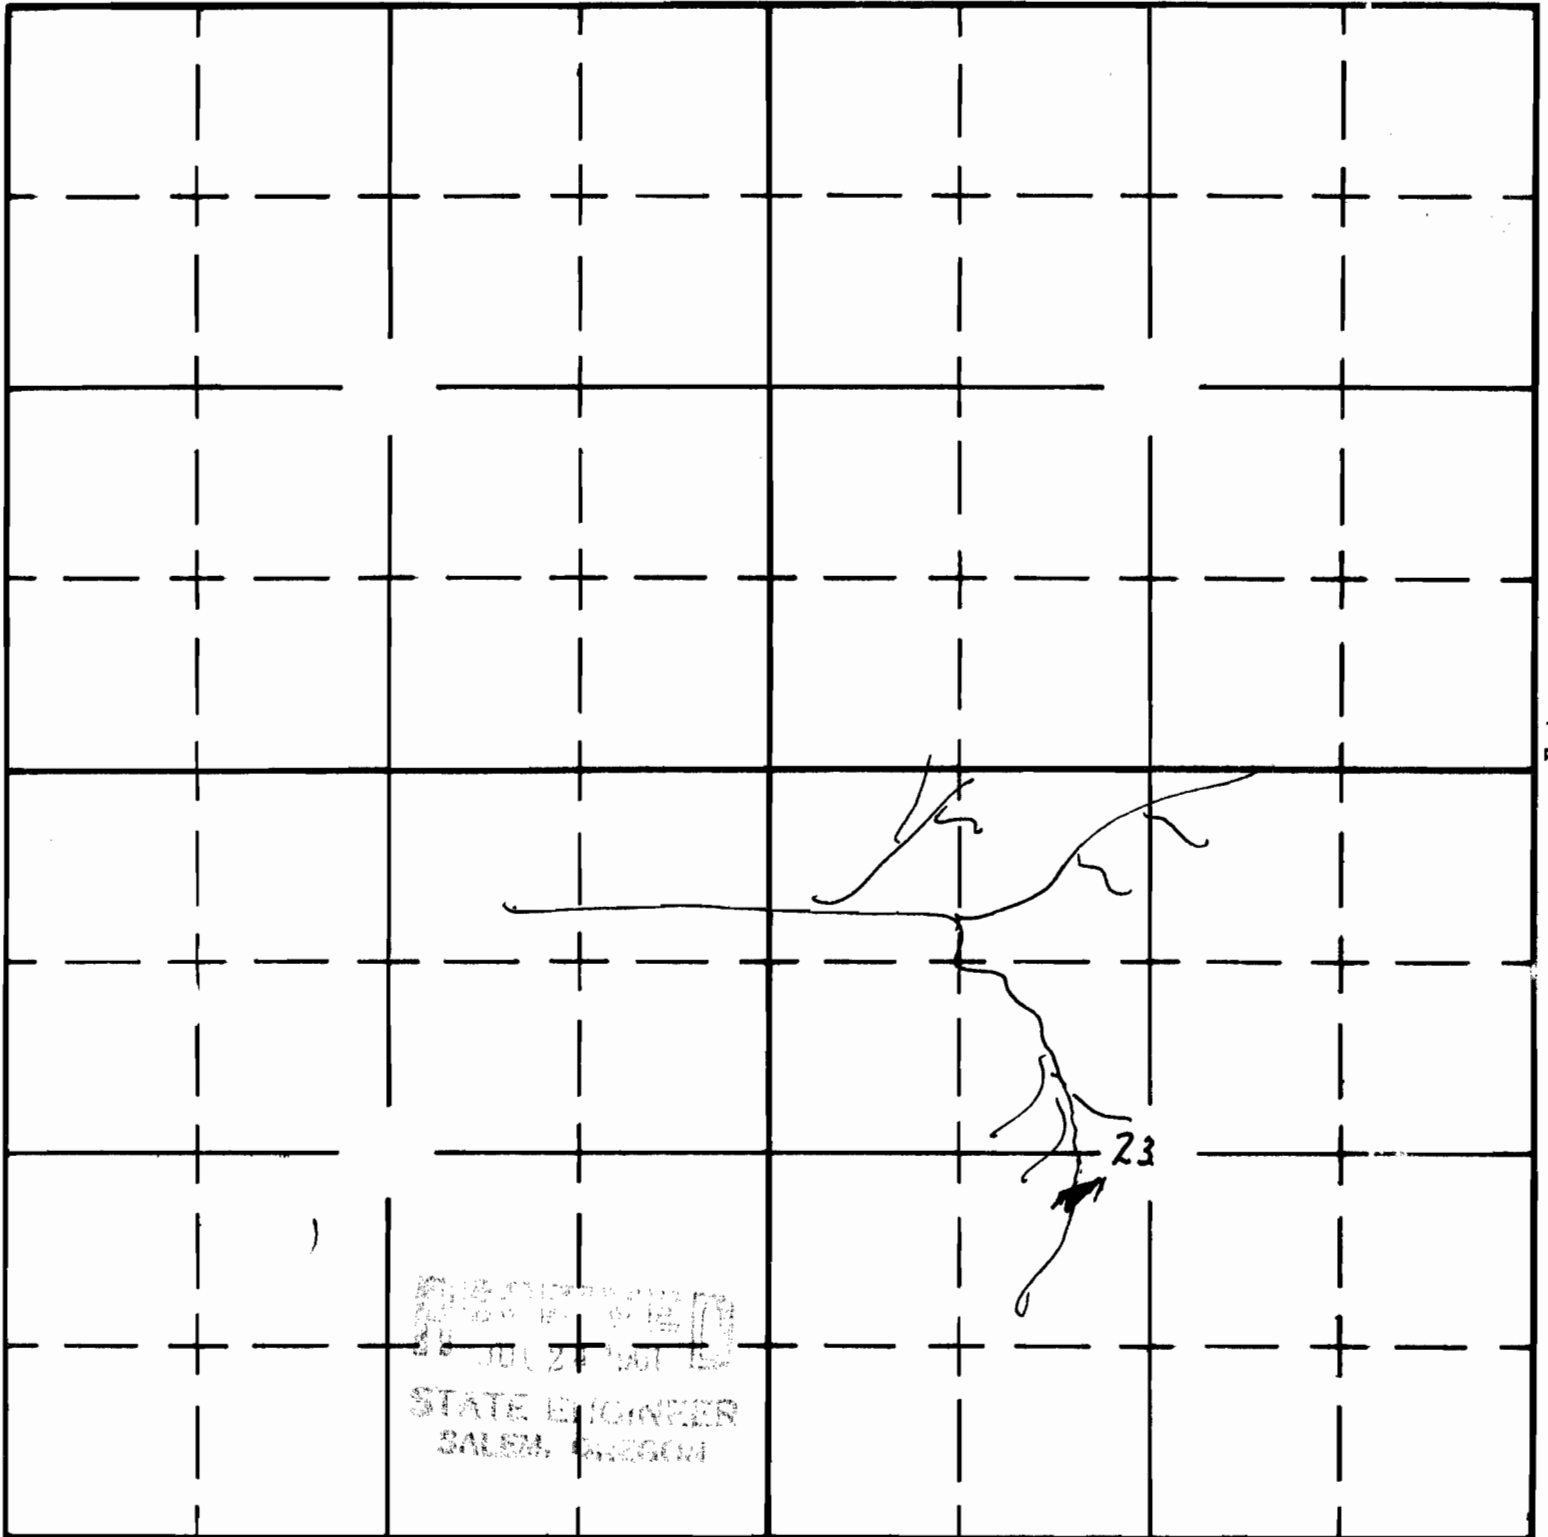

South

APPLICATION No. R-35449
PERMIT No. R-3314