

Form AI-187
March 1961

UNITED STATES
DEPARTMENT OF THE INTERIOR
BUREAU OF LAND MANAGEMENT


SECTION

SW 1/4 NW 1/4

Oregon State Water Filings

12TOWNSHIP 31S, RANGE 31E, W. M.

North

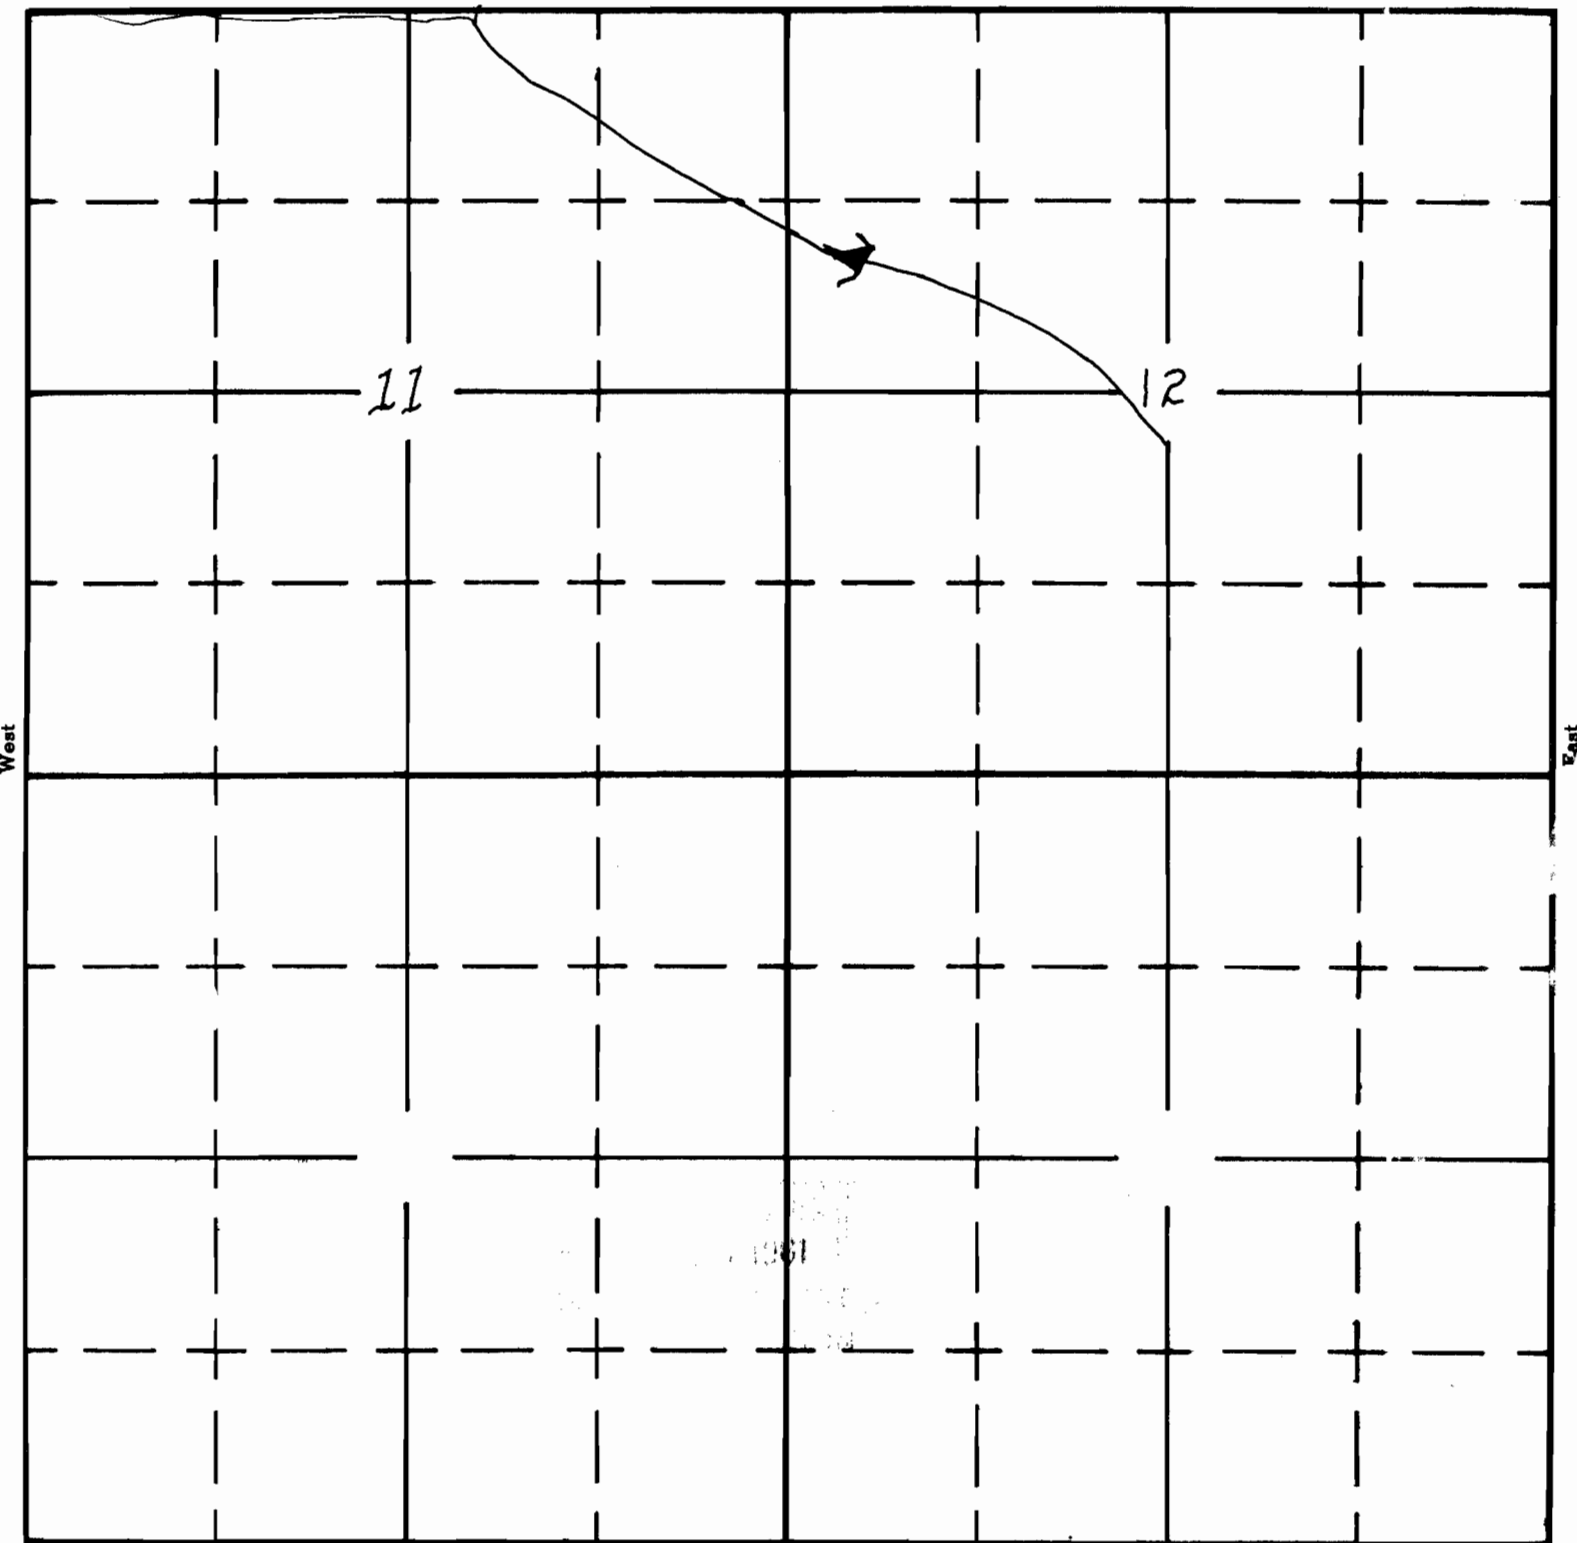

South

APPLICATION No. R-35471
PERMIT No. R-3334