

Form A1-187
March 1961

UNITED STATES
DEPARTMENT OF THE INTERIOR
BUREAU OF LAND MANAGEMENT


SECTION

32

Oregon State Water Filings

TOWNSHIP 30s, RANGE 33e, W. M.

North

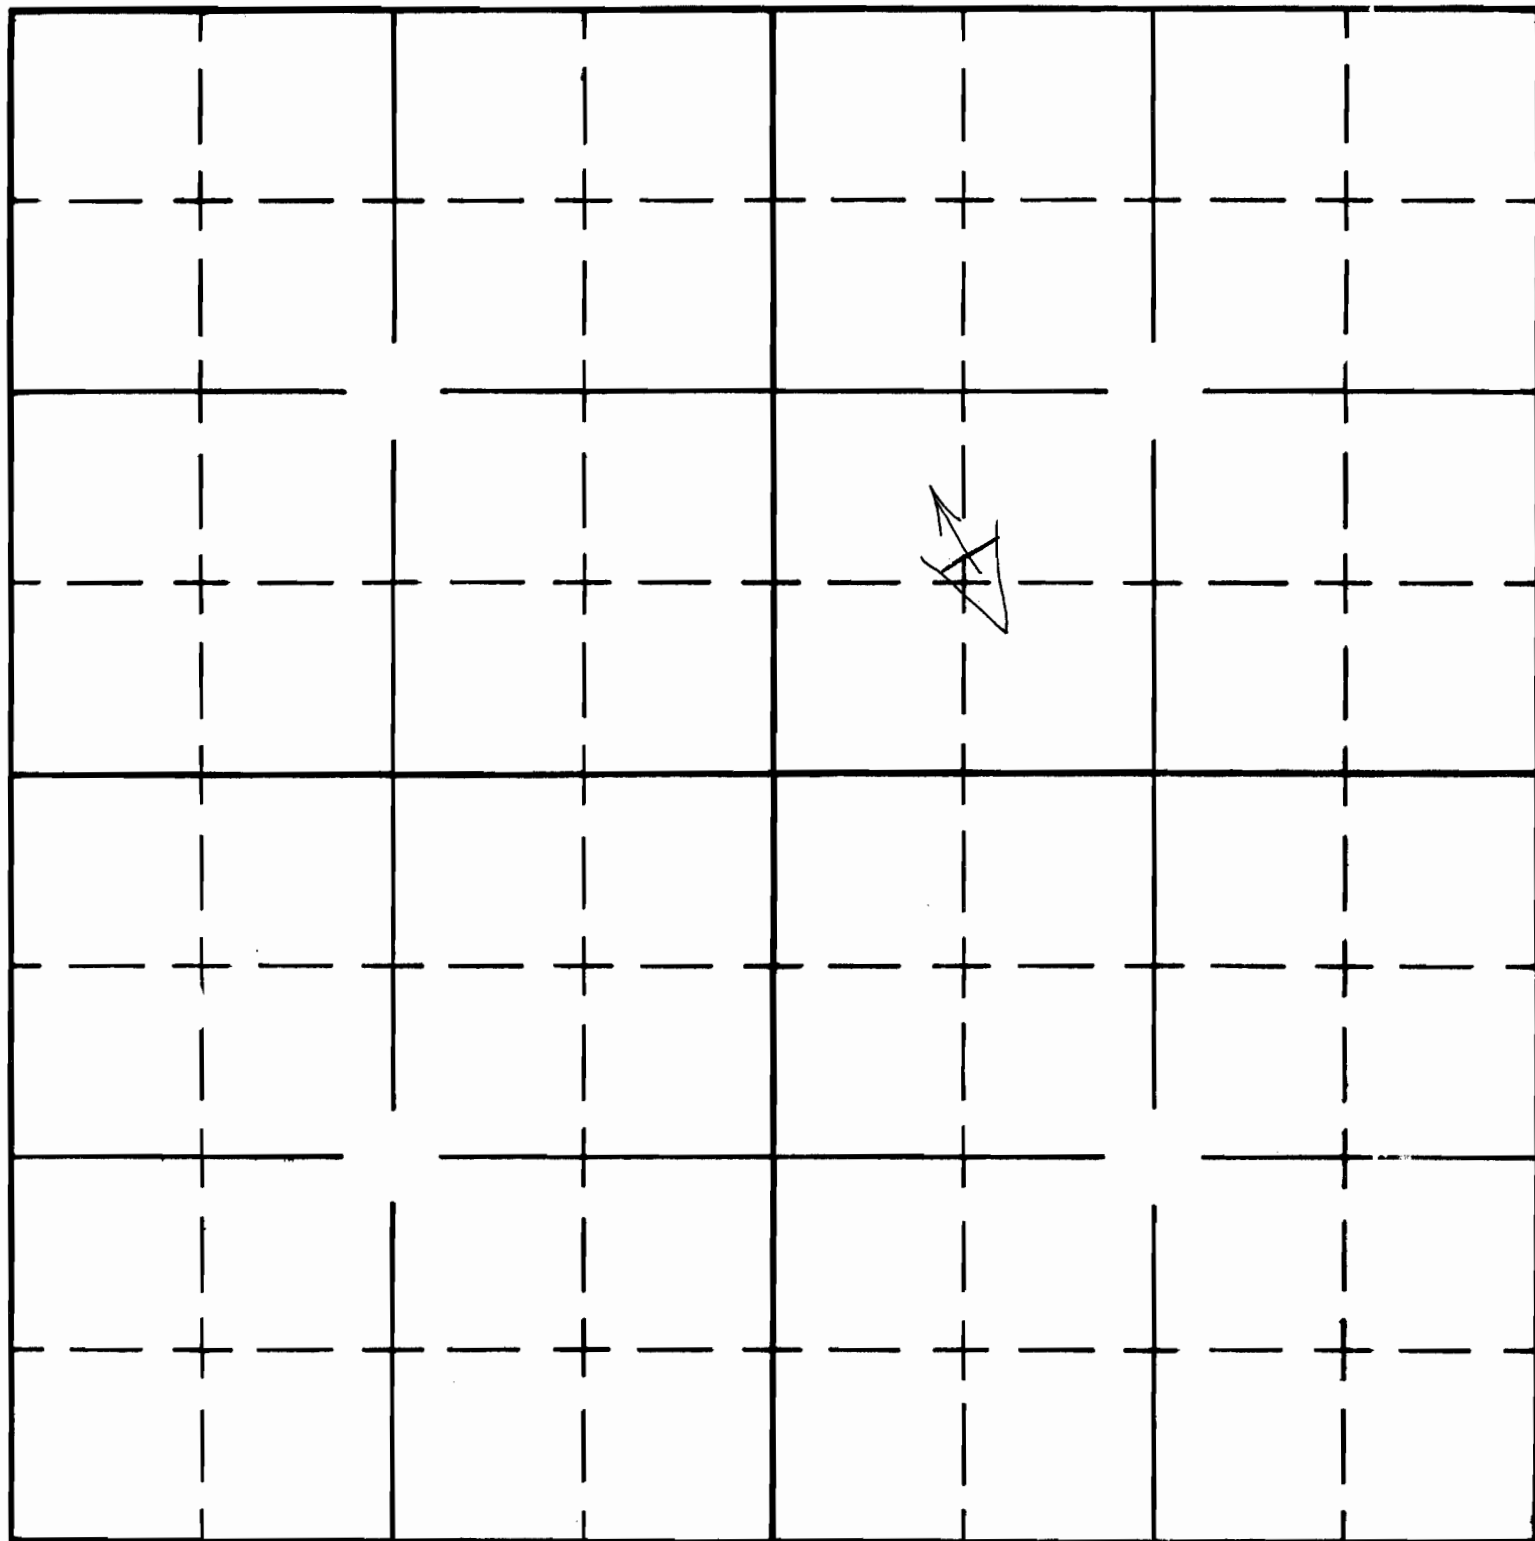

South

APPLICATION No. R-38297
PERMIT No. R-3411