

UNITED STATES
DEPARTMENT OF THE INTERIOR
BUREAU OF LAND MANAGEMENT

08-6801-1125


SECTION

Oregon State Water Filings

~~1/4 NW 1/4~~
SESW
Sec ~~25~~ 25

TOWNSHIP 30S, RANGE 29 3/4 W. M.

North

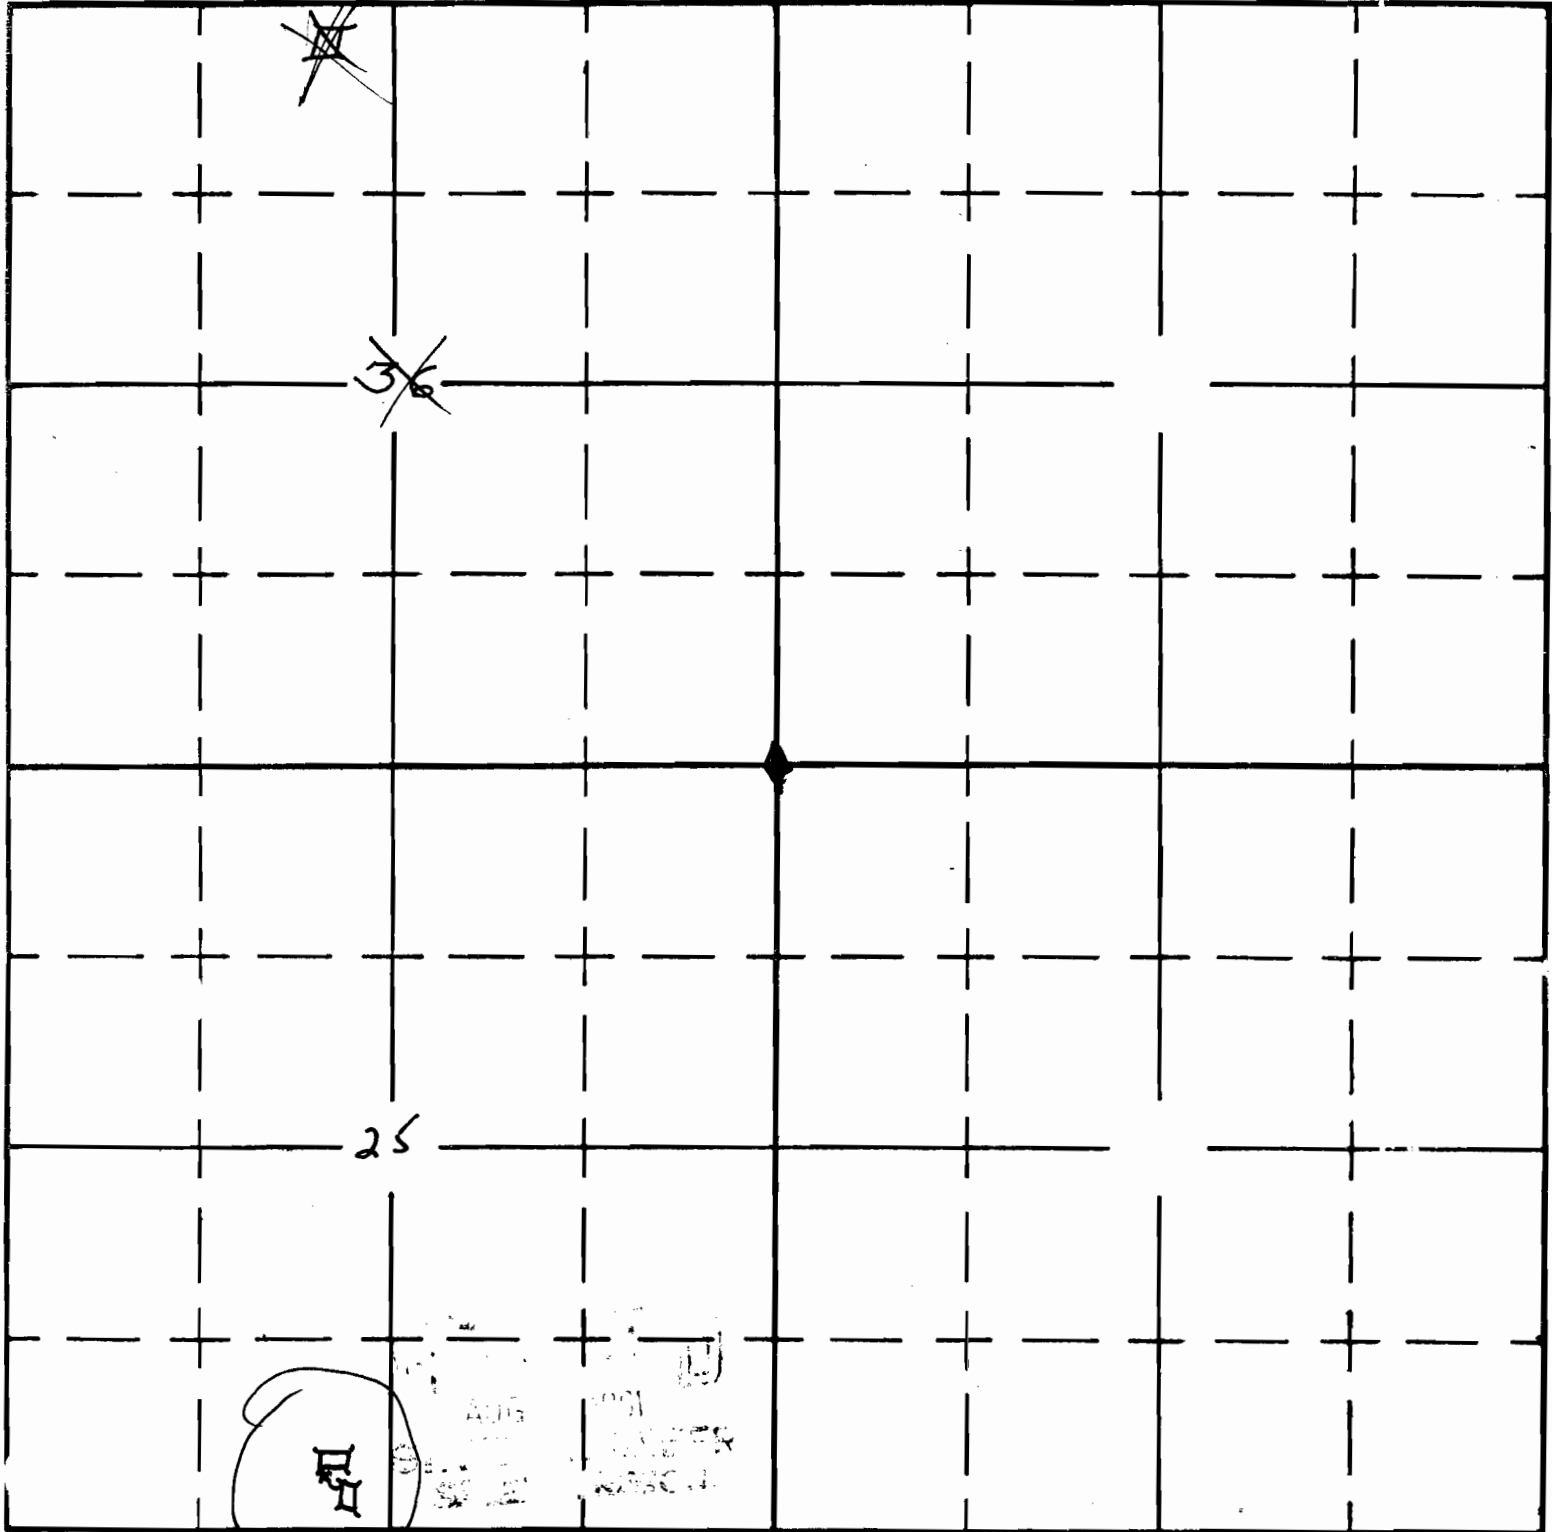

South

APPLICATION No. R-35921
PERMIT No. R-3458

UNITED STATES
DEPARTMENT OF THE INTERIOR
BUREAU OF LAND MANAGEMENT

SECTION


Oregon State Water Filings

NE 1/4 NW 1/4

TOWNSHIP 30S, RANGE 29 3/4 W. M.

Sec 36

North

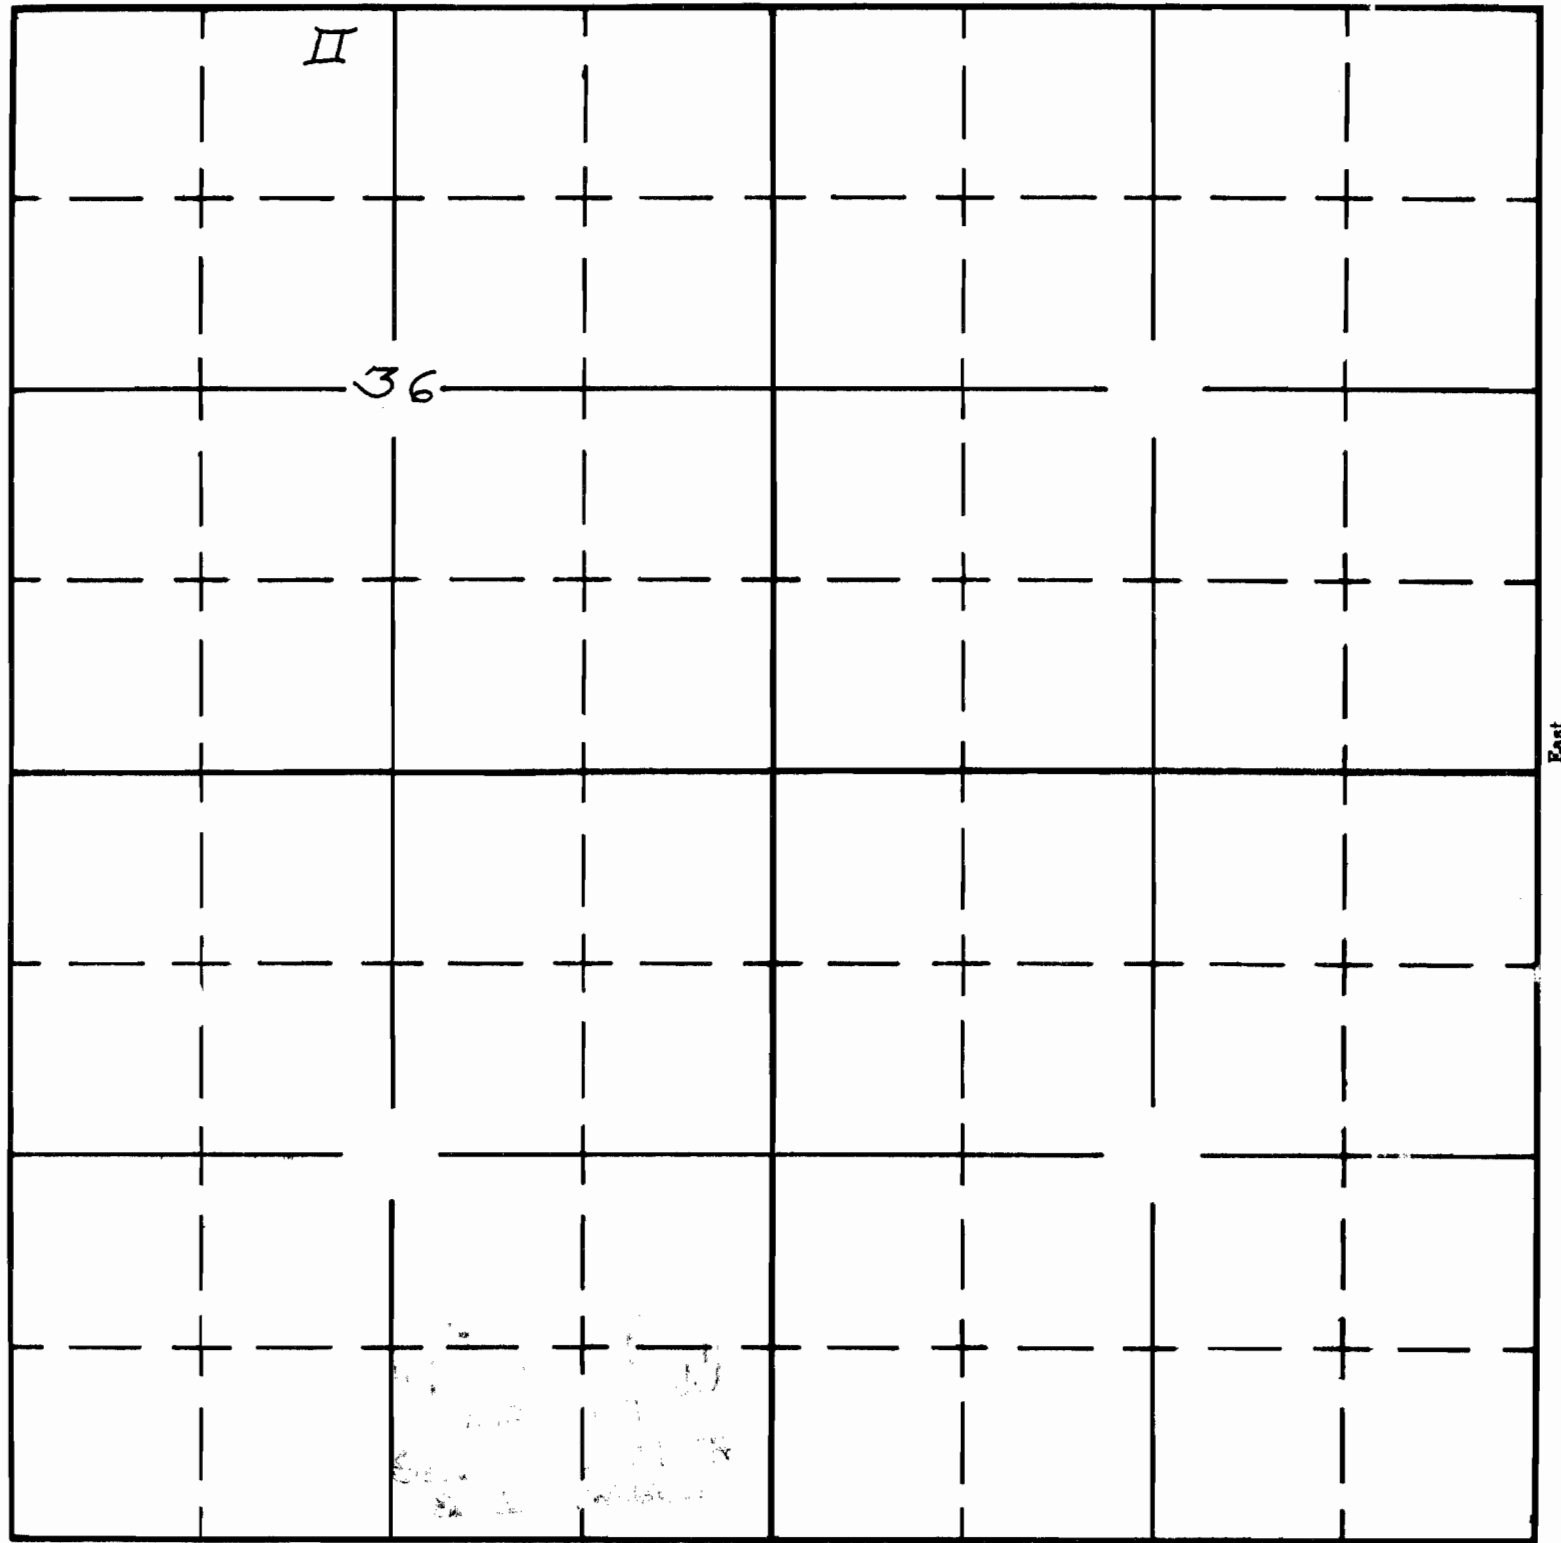

South