

UNITED STATES
DEPARTMENT OF THE INTERIOR
BUREAU OF LAND MANAGEMENT

SECTION


Oregon State Water Filings

NE 1/4 SE 1/4

TOWNSHIP 38, RANGE 32E, W. M.

Sec 22

North

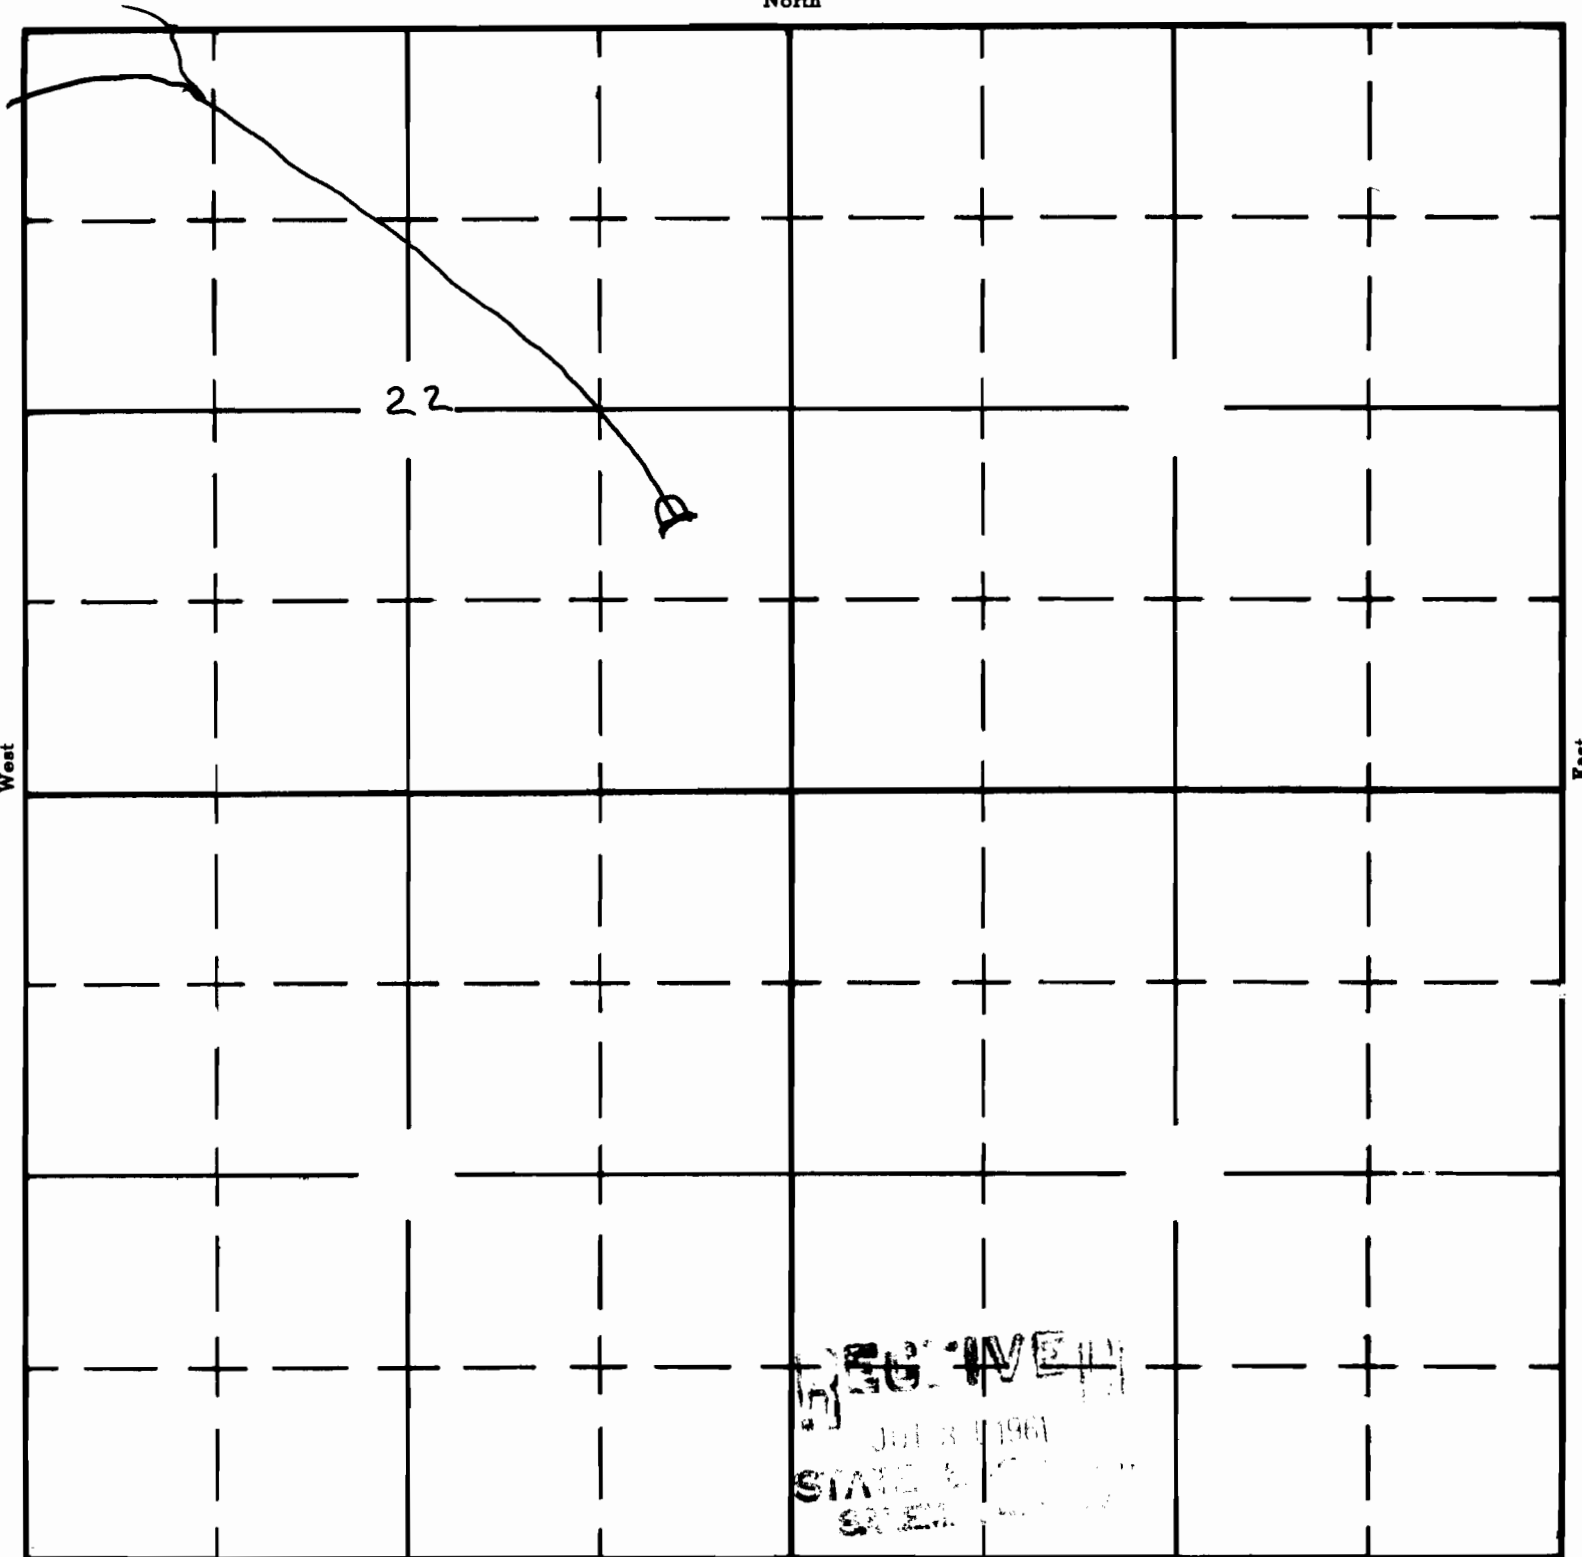

South

APPLICATION No. **R-35827**
PERMIT No. **R-3476**