


UNITED STATES
DEPARTMENT OF THE INTERIOR
BUREAU OF LAND MANAGEMENT

SECTION SW 1/4 NW 1/4 Oregon State Water Filings

9

TOWNSHIP 40S, RANGE 37E, W. M.

North

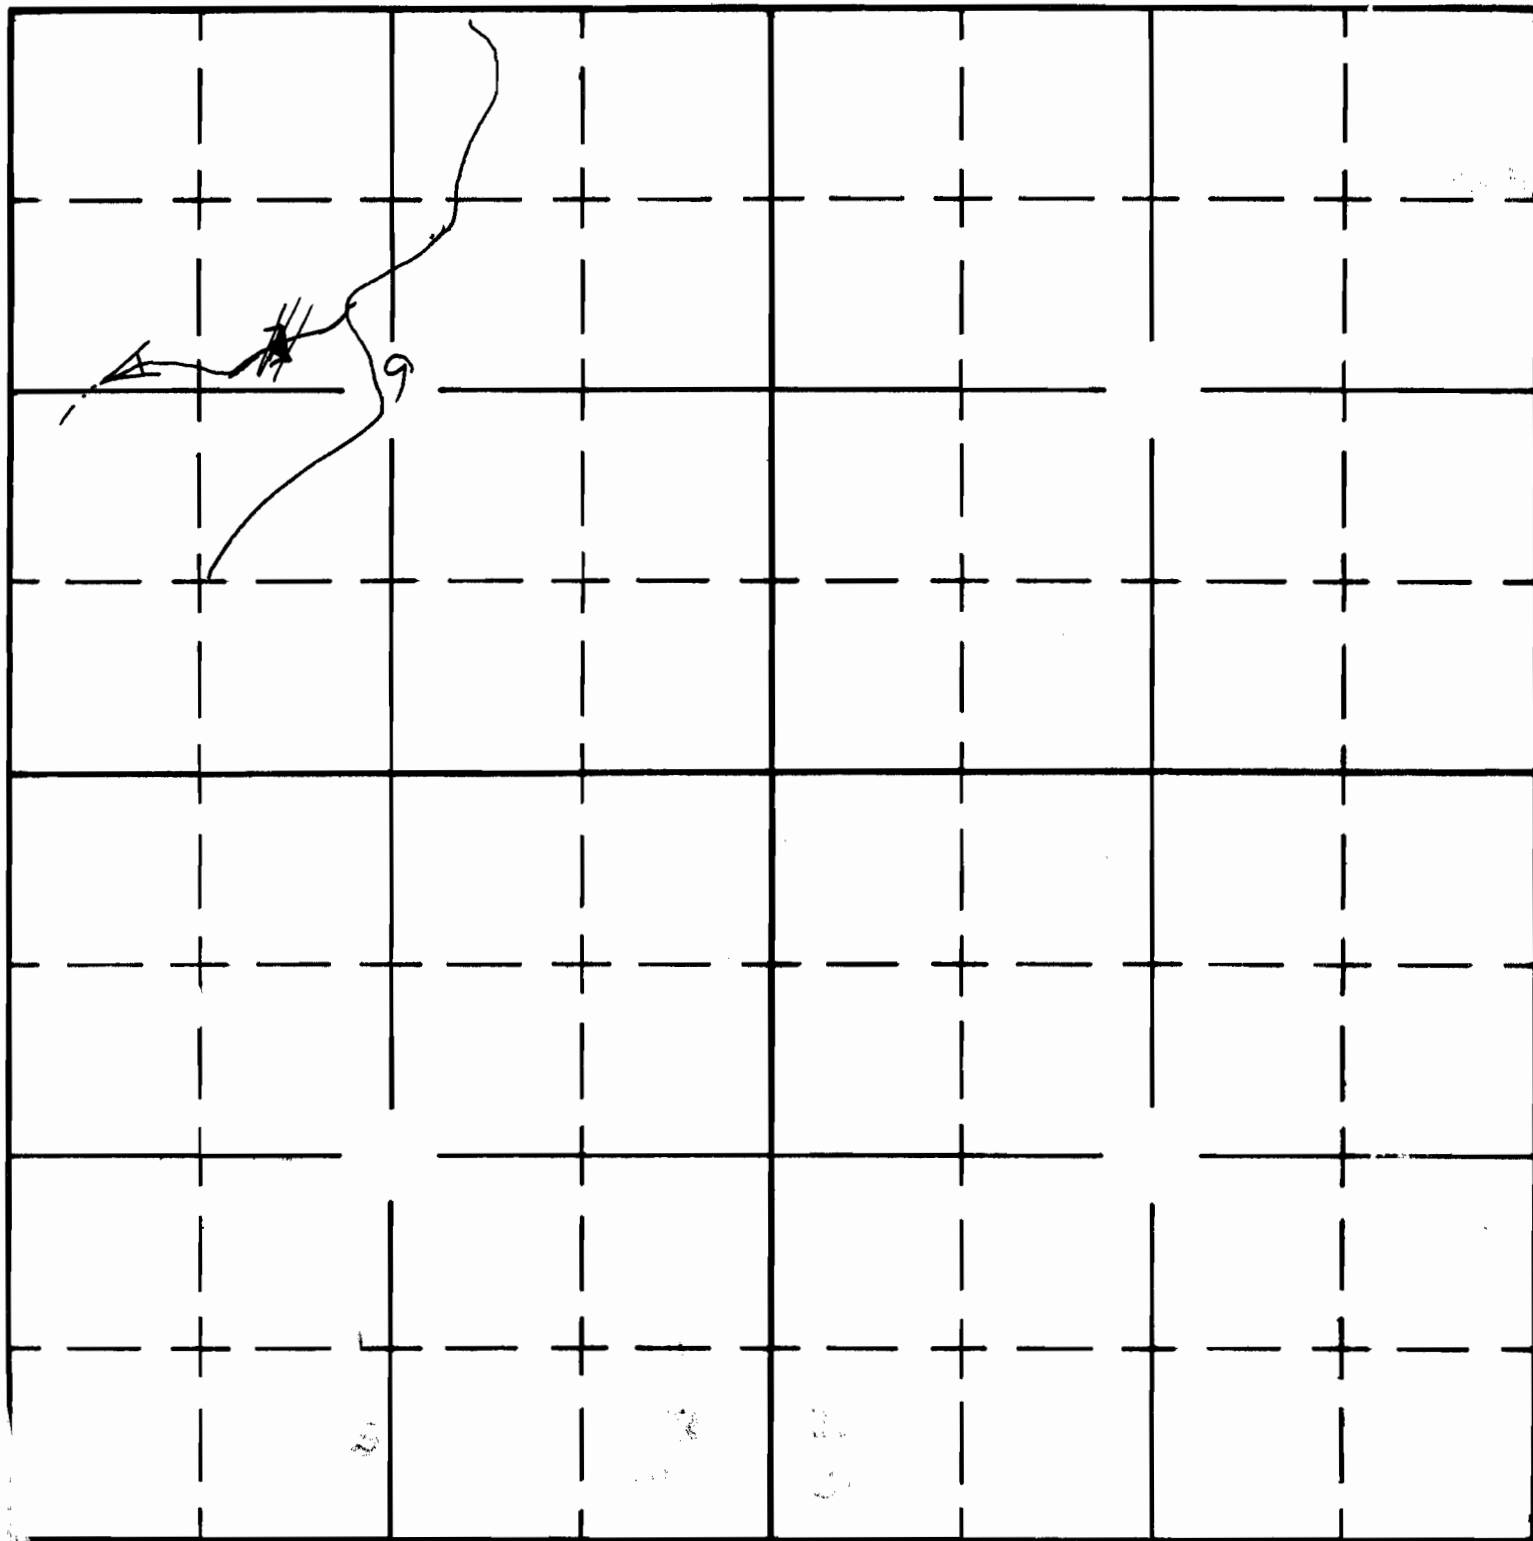

South

APPLICATION No. R-35409
PERMIT No. R-3513