

Form A1-187
March 1961

UNITED STATES
DEPARTMENT OF THE INTERIOR
BUREAU OF LAND MANAGEMENT

SECTION


NE $\frac{1}{4}$ SW $\frac{1}{4}$

Oregon State Water Filings

SEC 2

TOWNSHIP 25S, RANGE 29E, W. M.

North

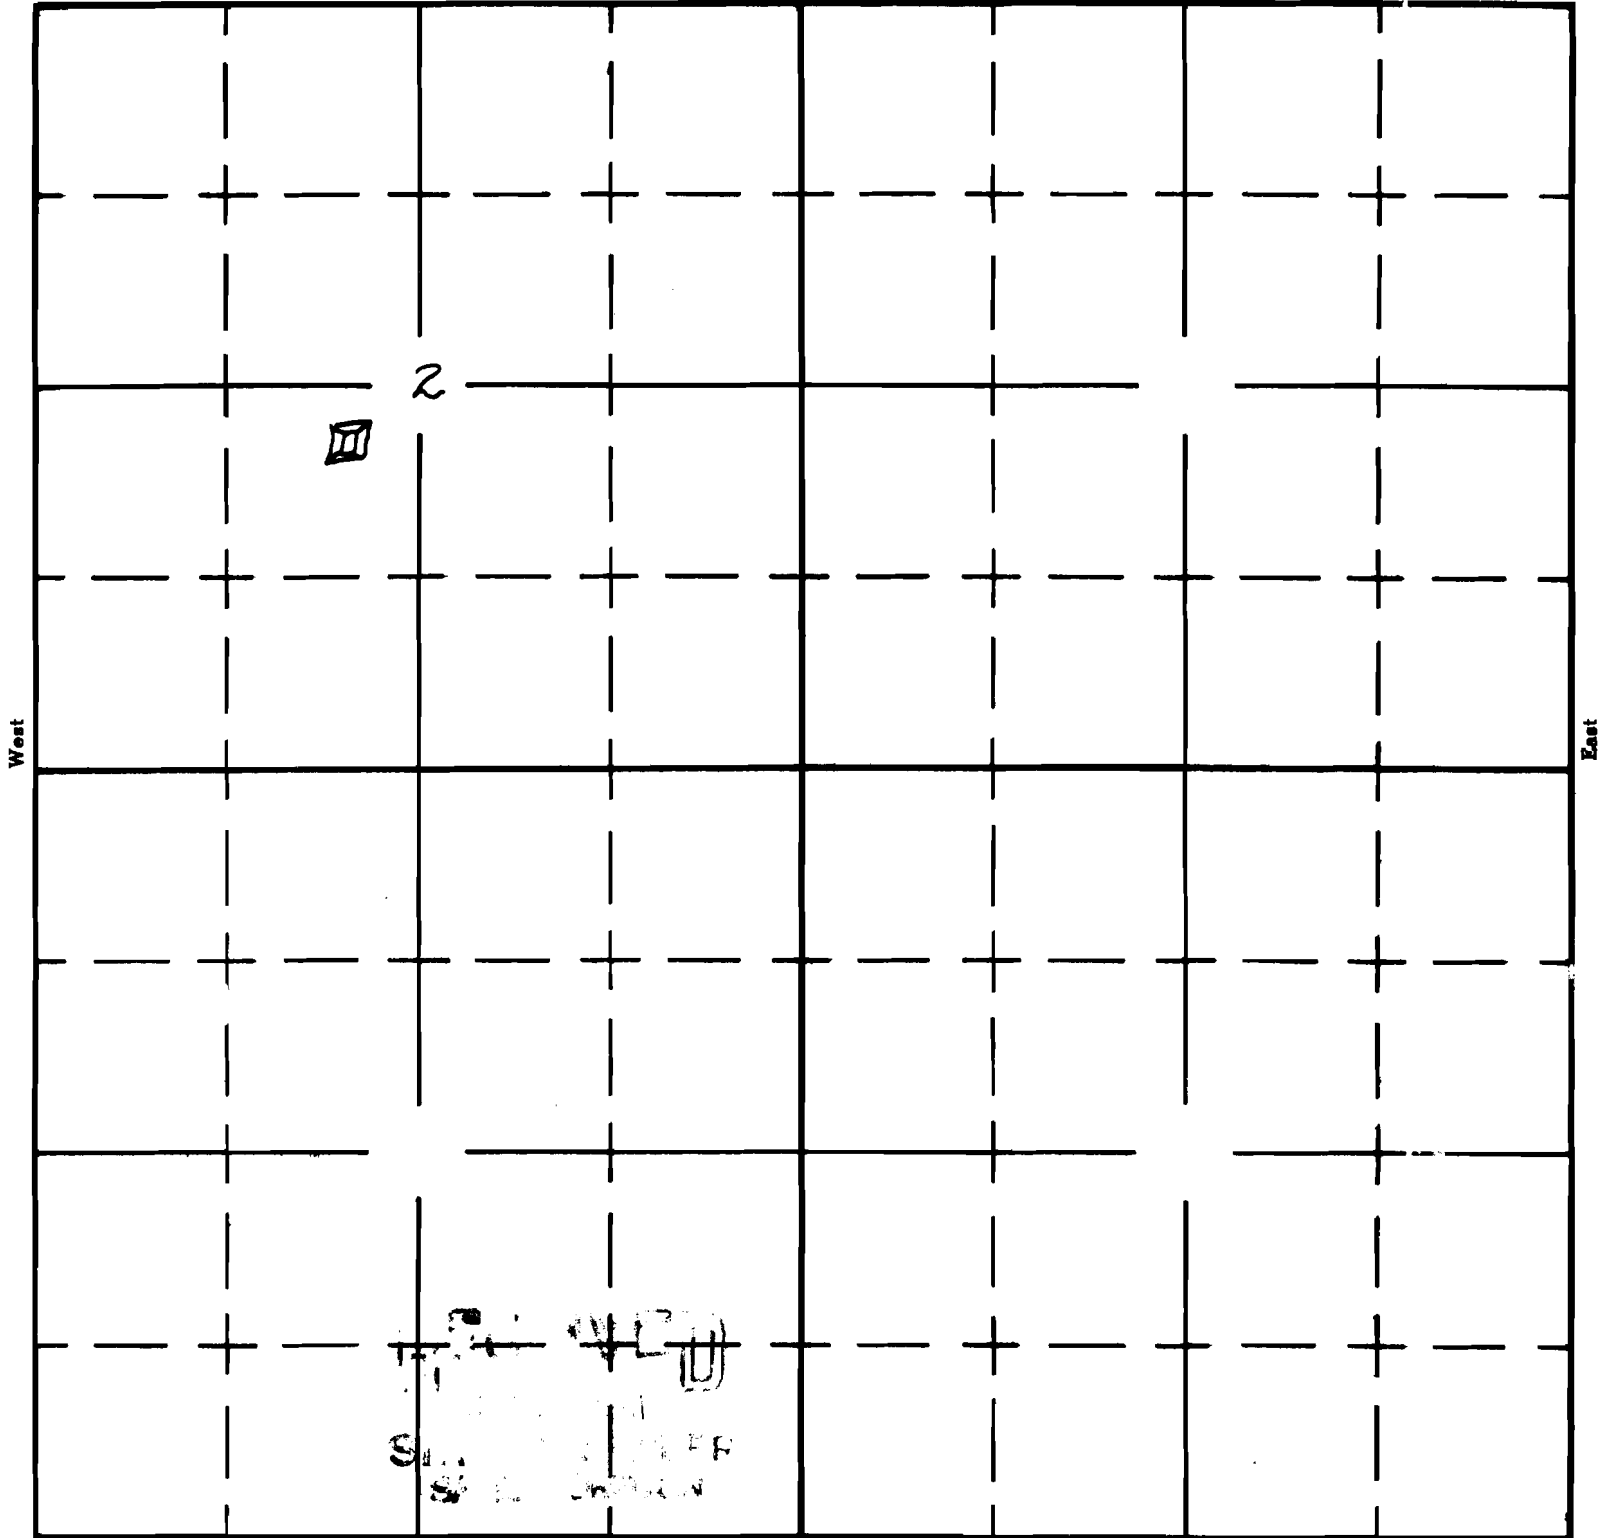

APPLICATION No. R-35852
PERMIT No. R-3906