

Form A1-187
March 1961

UNITED STATES
DEPARTMENT OF THE INTERIOR
BUREAU OF LAND MANAGEMENT


SECTION

SW 1/4 SK 1/2 Oregon State Water Filings

Sec 28

TOWNSHIP 39 S RANGE 37 E, W. M.

North

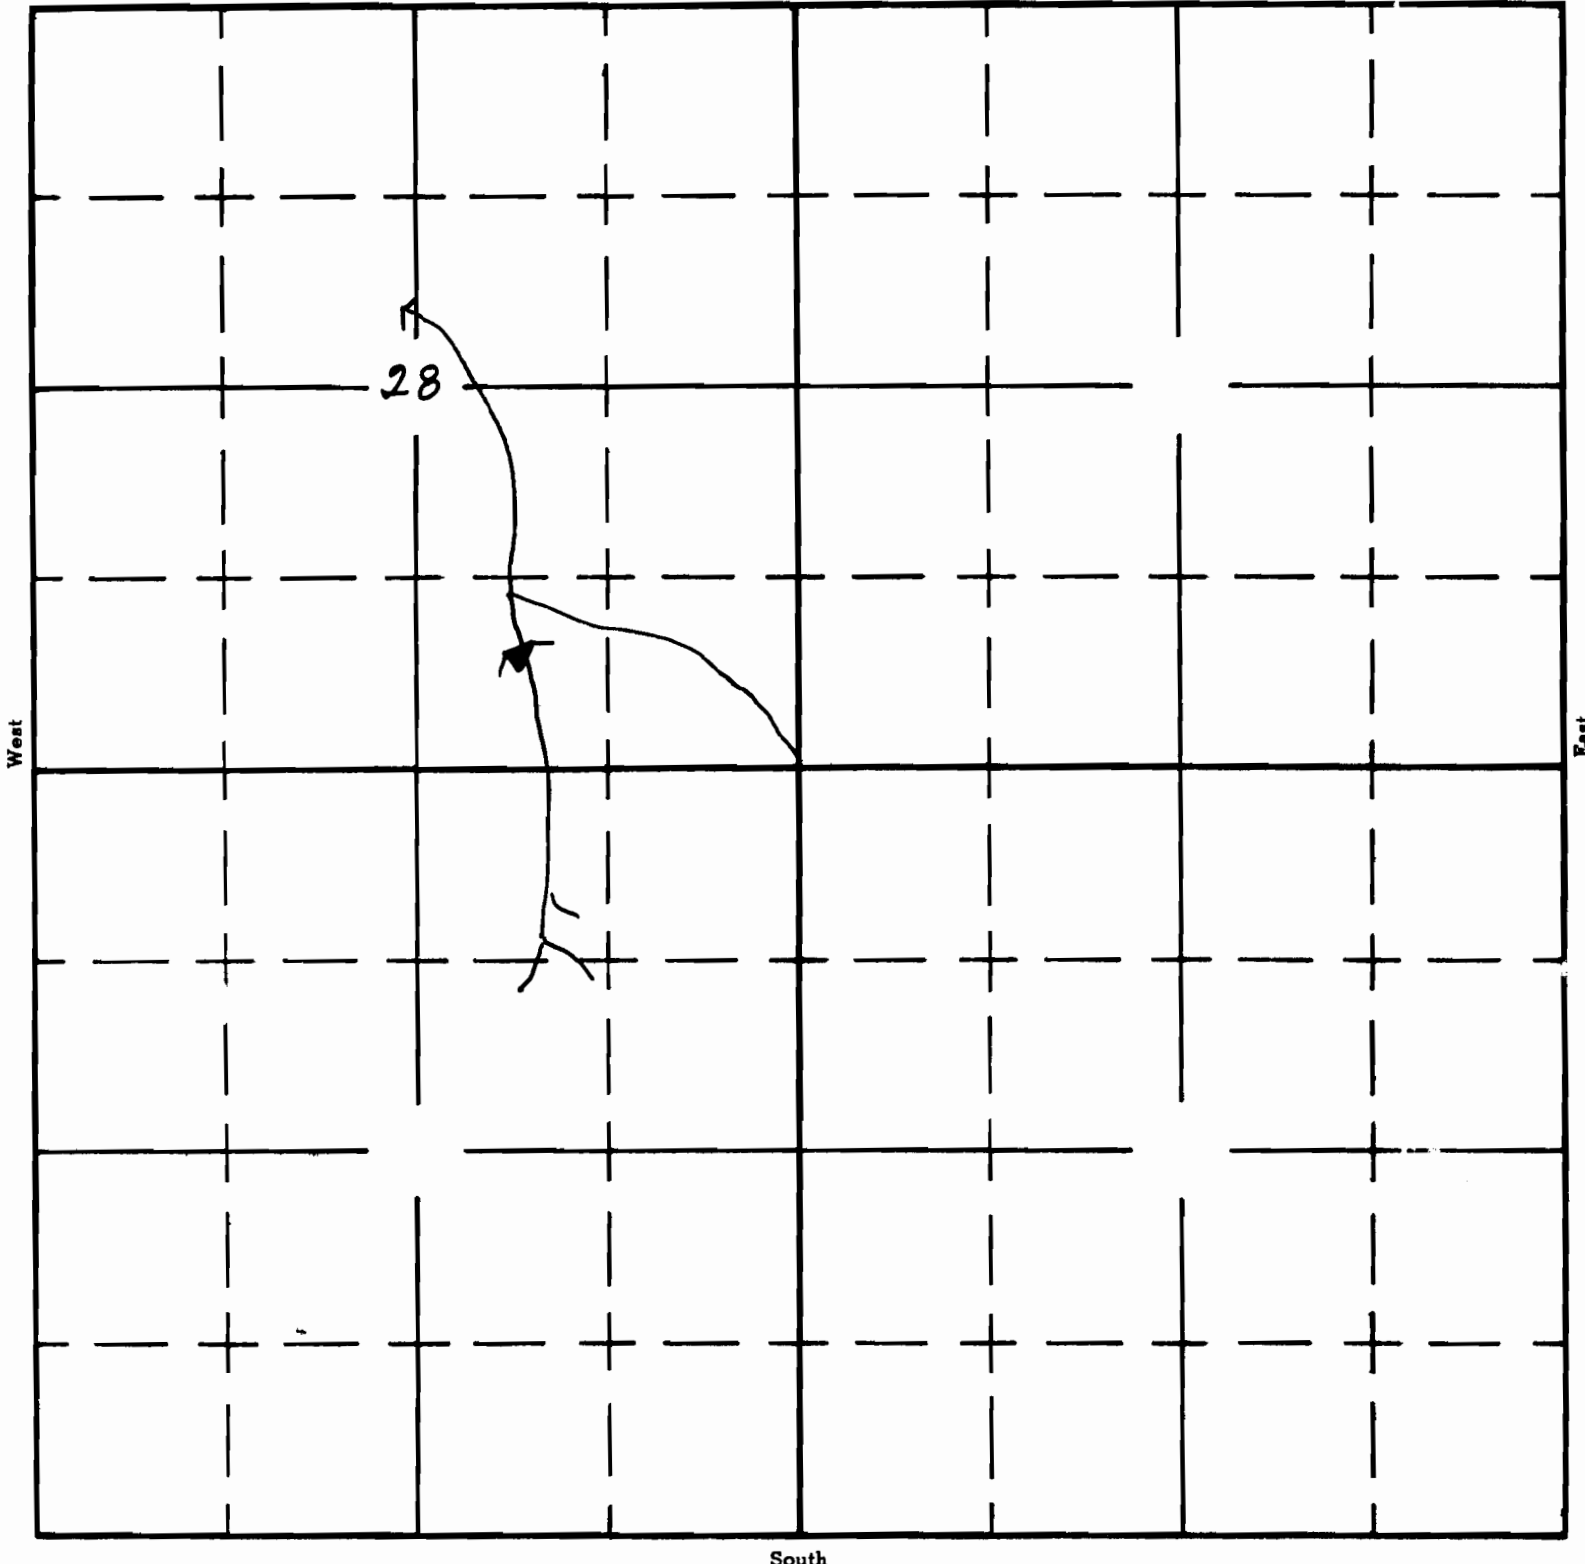

South

APPLICATION No. R-35507
PERMIT No. R-4003