

Form AI-187
March 1961


UNITED STATES
DEPARTMENT OF THE INTERIOR
BUREAU OF LAND MANAGEMENT

SECTION SW 1/4 SE 1/4

Oregon State Water Filings

20

TOWNSHIP 39S, RANGE 38E, W. M.

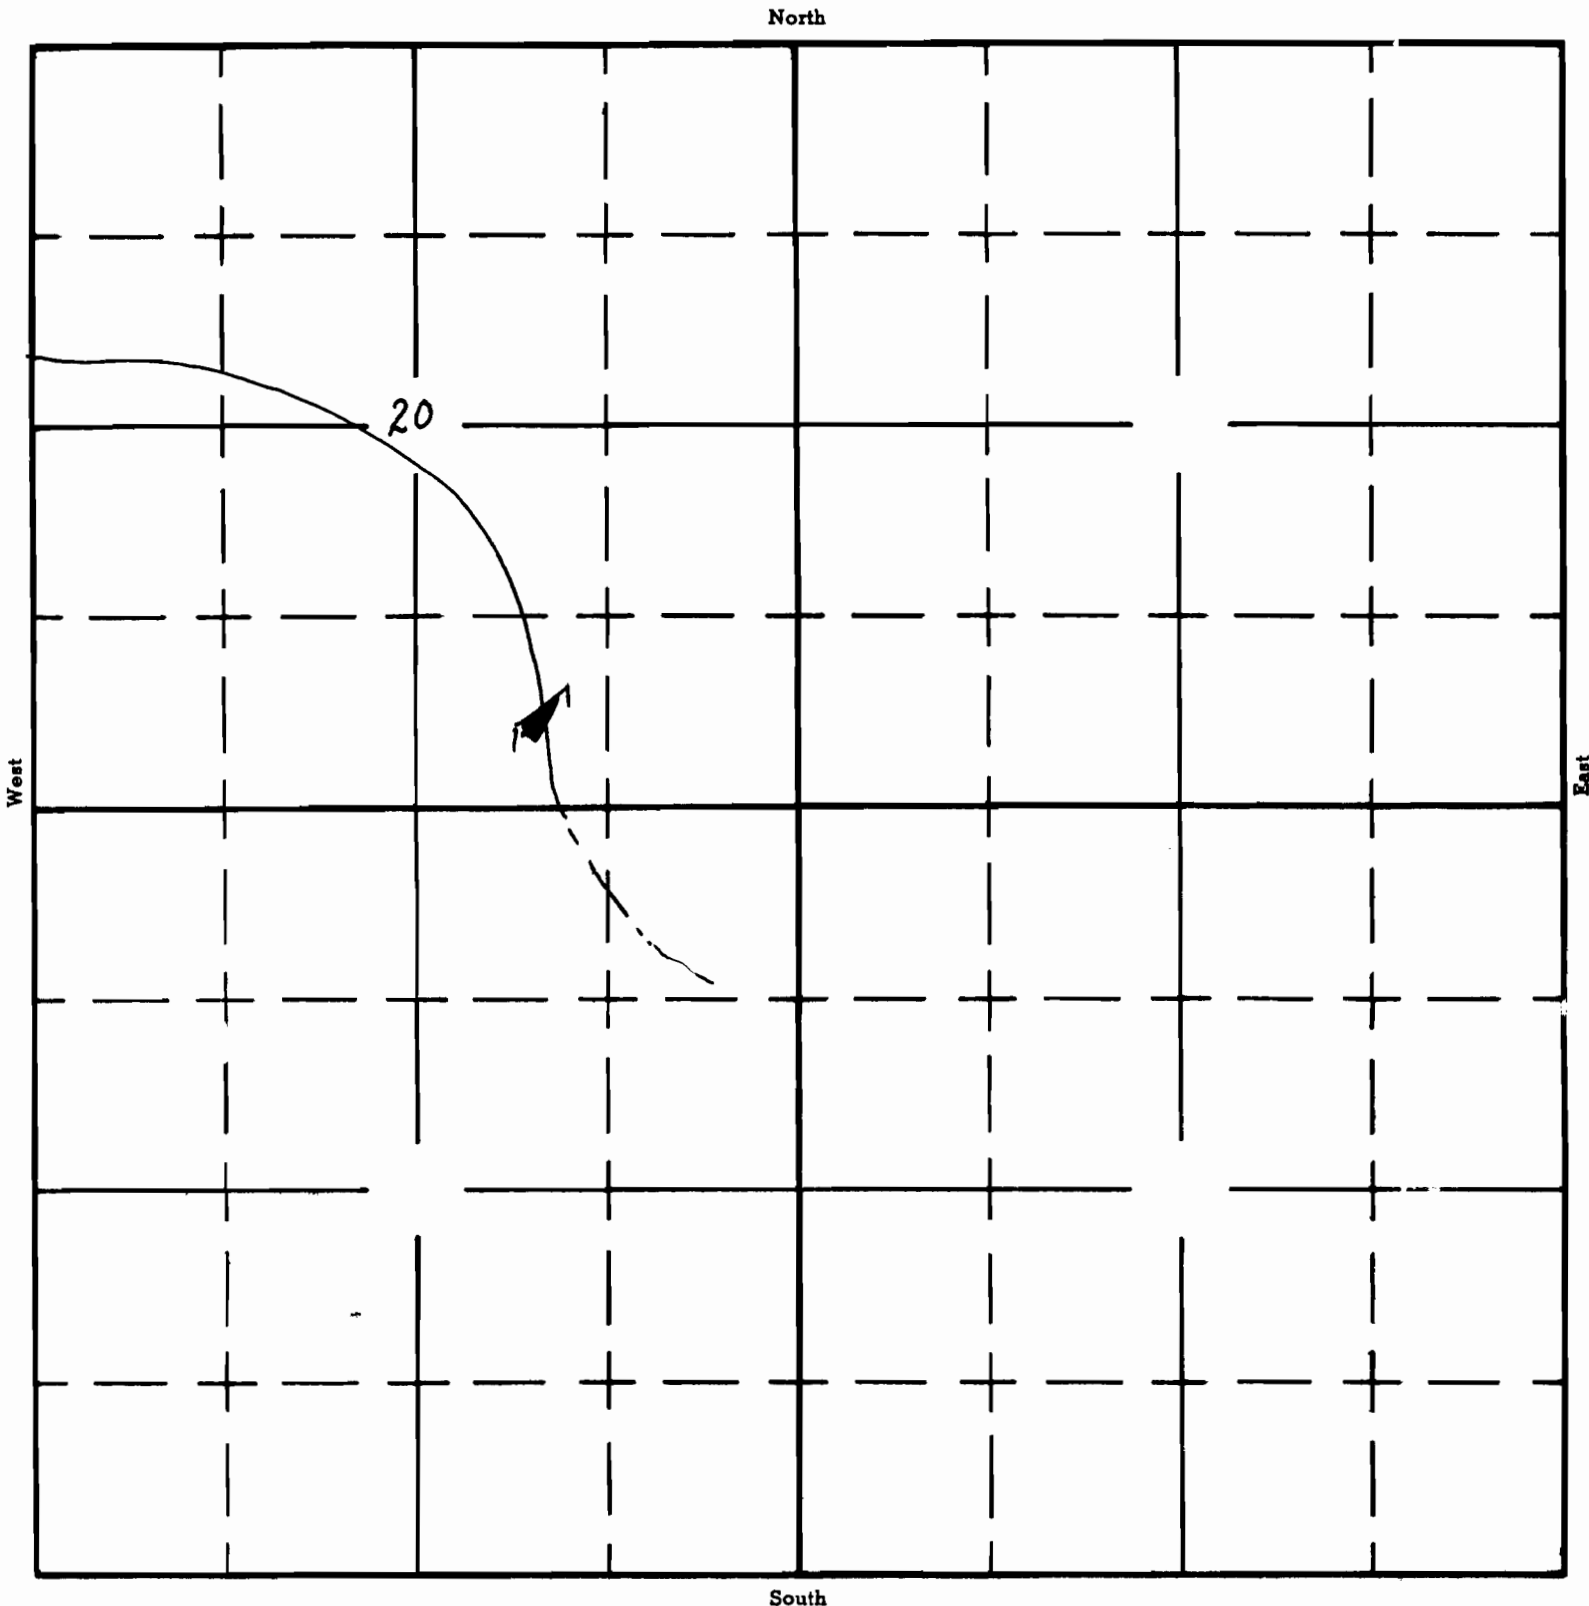

APPLICATION No. R-35508

PERMIT No. R-4004