

Form AI-187
March 1961

UNITED STATES
DEPARTMENT OF THE INTERIOR
BUREAU OF LAND MANAGEMENT


SECTION

Sec 6

Oregon State Water Filings

Lot 4

TOWNSHIP 4/S, RANGE 32E, W. M.

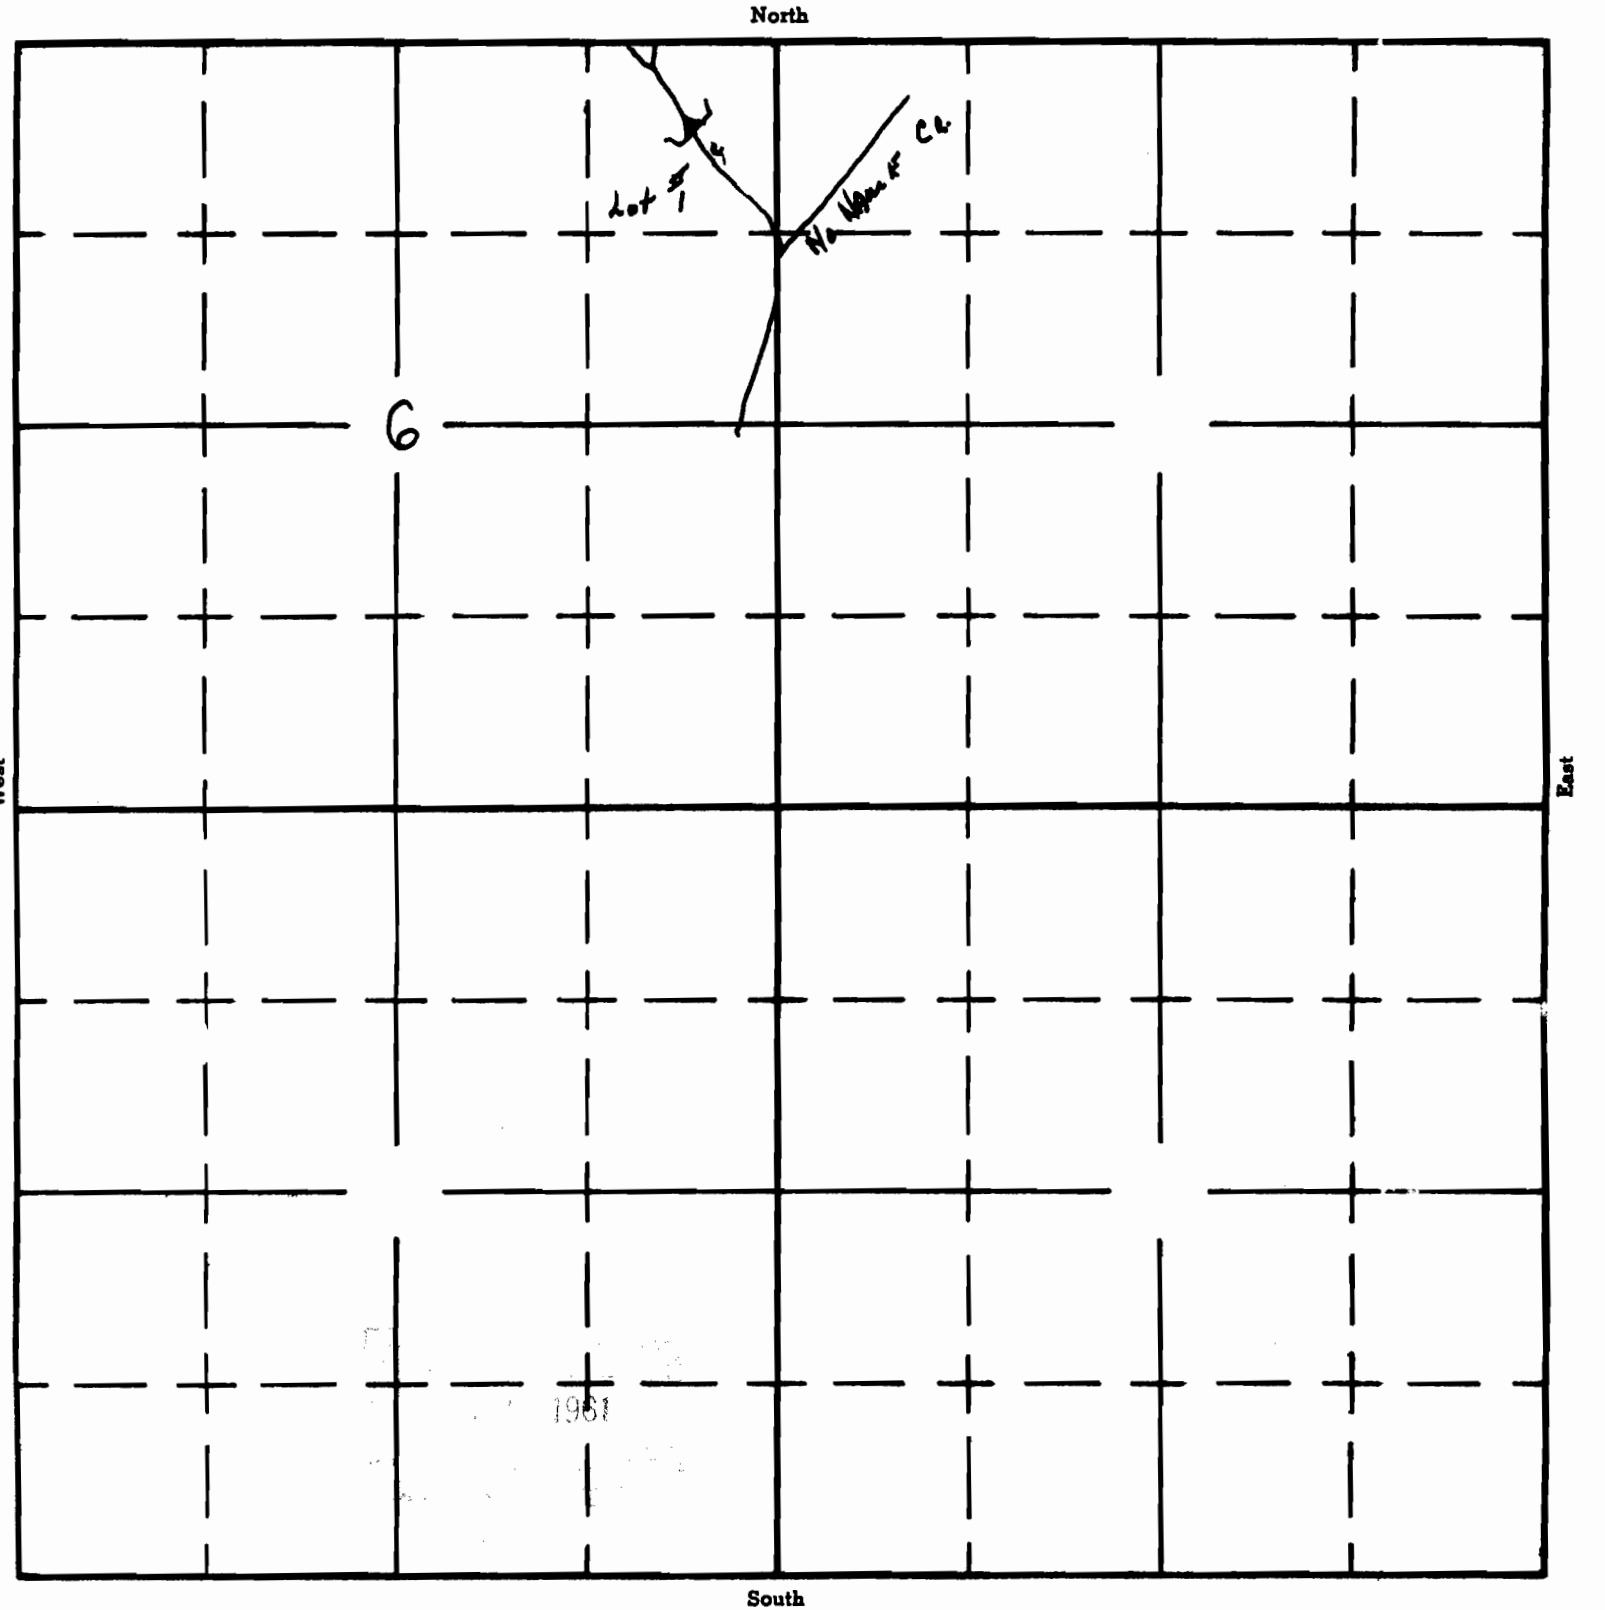

APPLICATION No. R-35517

PERMIT No. R-4013