

Form AI-187
March 1961

UNITED STATES
DEPARTMENT OF THE INTERIOR
BUREAU OF LAND MANAGEMENT

SECTION


Oregon State Water Filings

NE 1/4 NW 1/4

TOWNSHIP 37S, RANGE 32 3/4W. M.

See 5

North

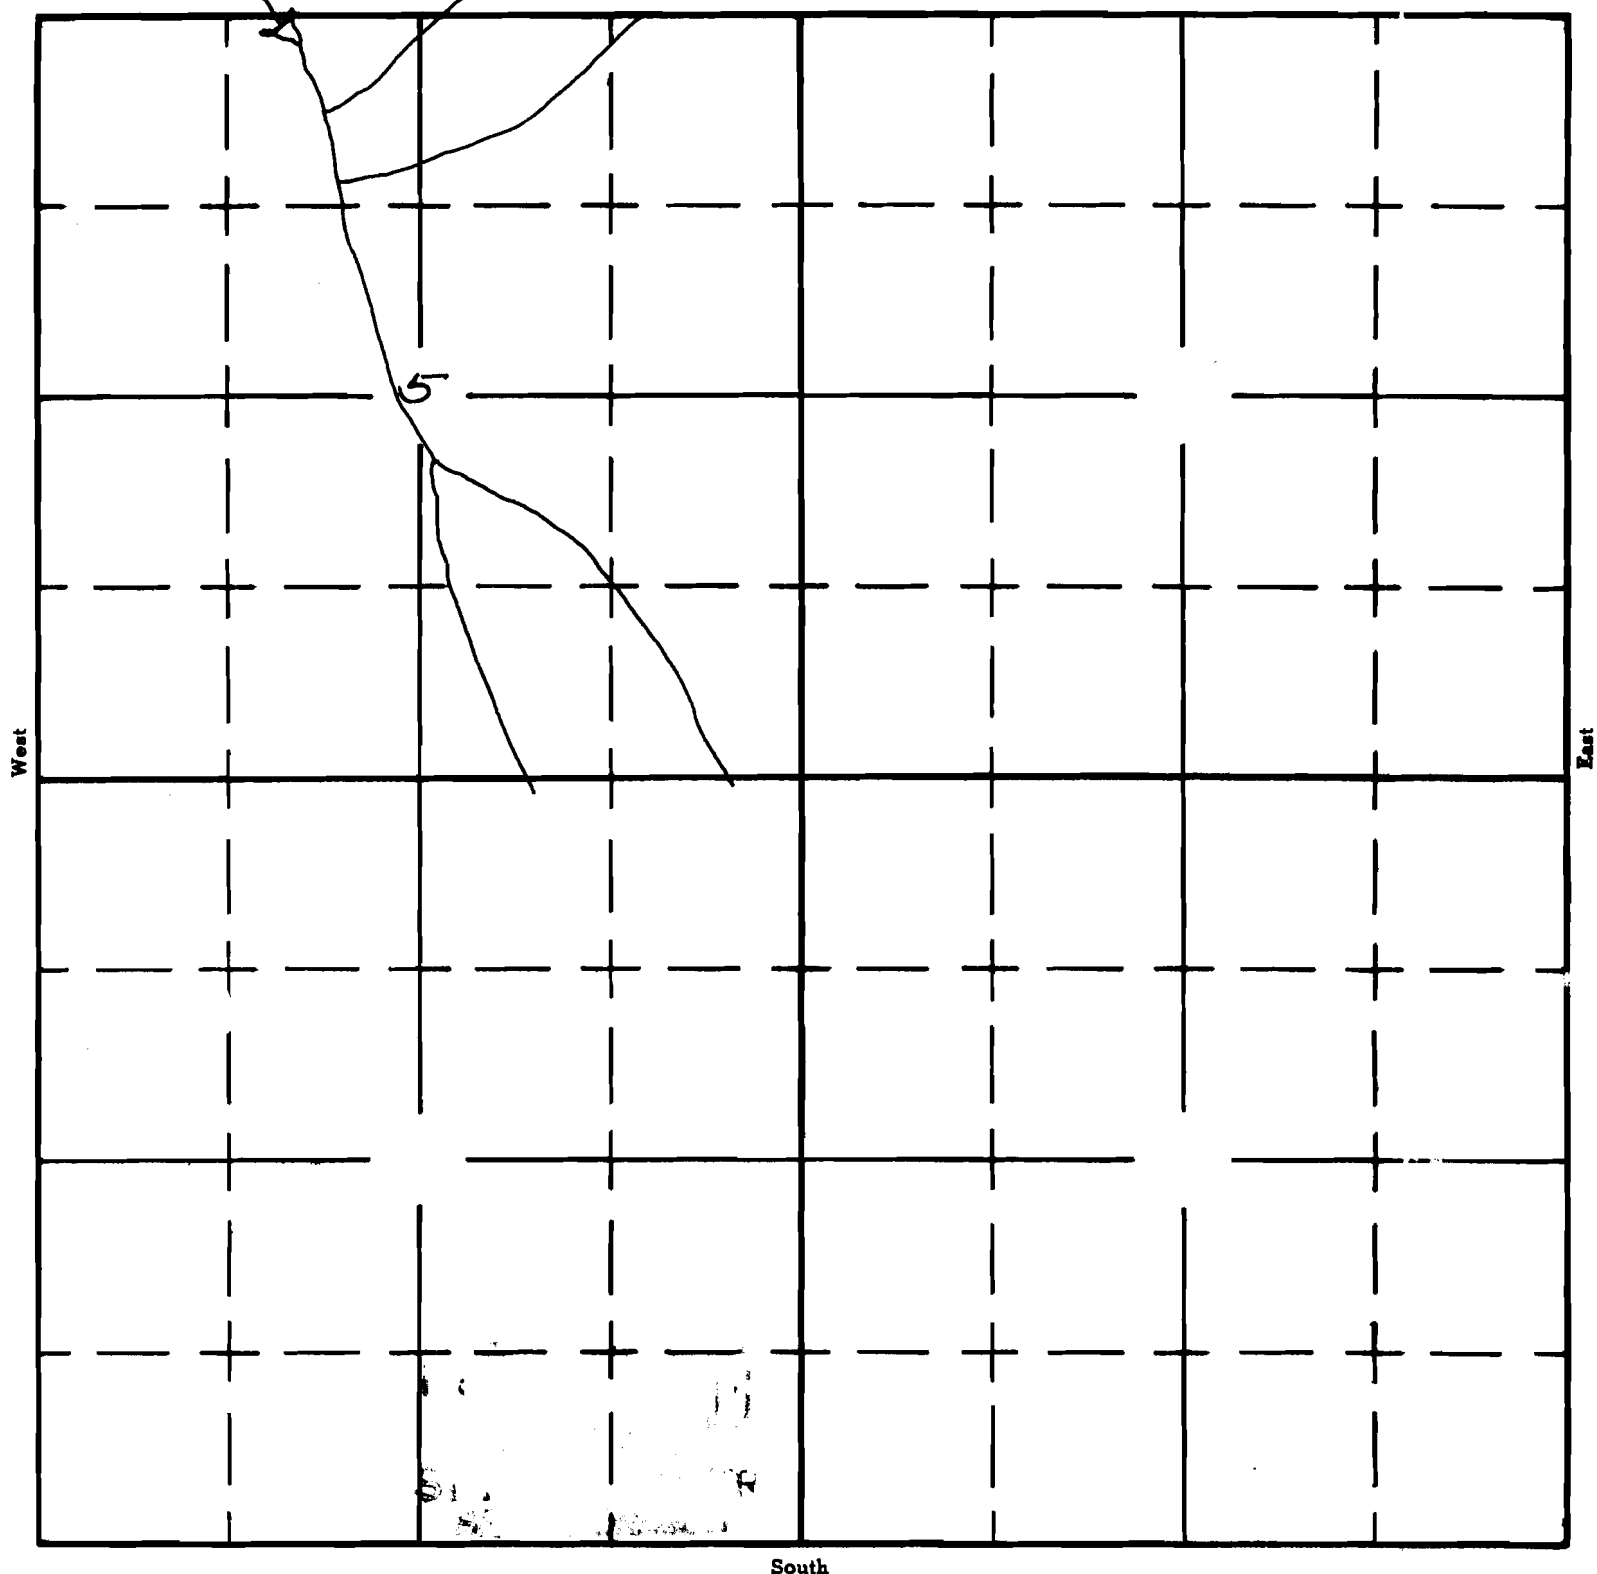

South

APPLICATION No. R-35679
PERMIT No. R-4035