

Form AI-187
March 1961

UNITED STATES
DEPARTMENT OF THE INTERIOR
BUREAU OF LAND MANAGEMENT

SECTION


Oregon State Water Filings

NW 1/4 SE 1/4

TOWNSHIP 37S, RANGE 32 1/4 W. M.

Sec 6

North

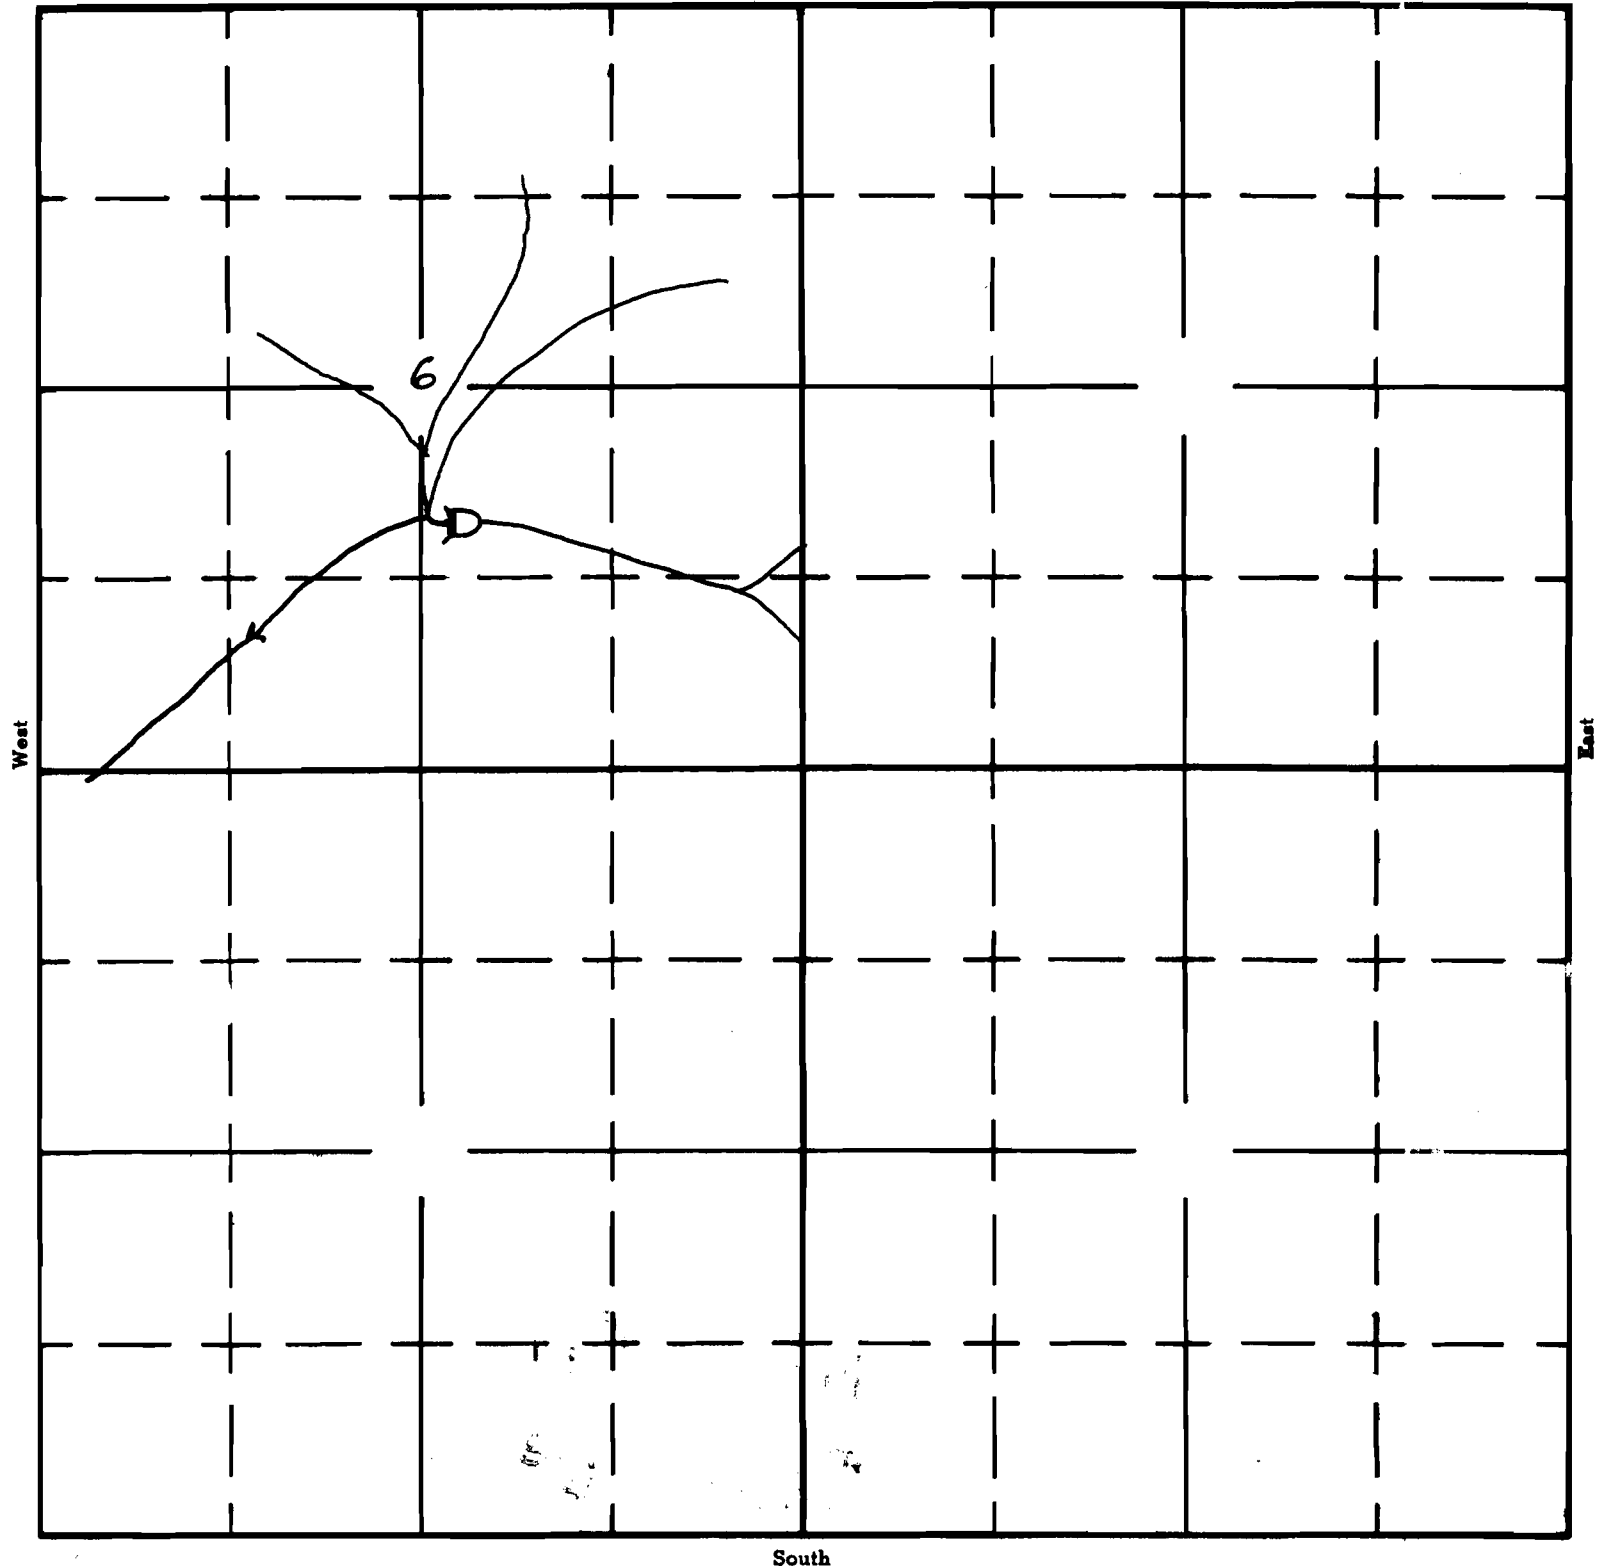

South

APPLICATION No. R-35680
PERMIT No. R-4036