


UNITED STATES
DEPARTMENT OF THE INTERIOR
BUREAU OF LAND MANAGEMENT

SECTION
W¹/₄ NE¹/₄
SW¹/₄ SW¹/₄
SEC. ~~22~~ 23

Oregon State Water Filings

TOWNSHIP 30 S, RANGE 32 E, W. M.

North

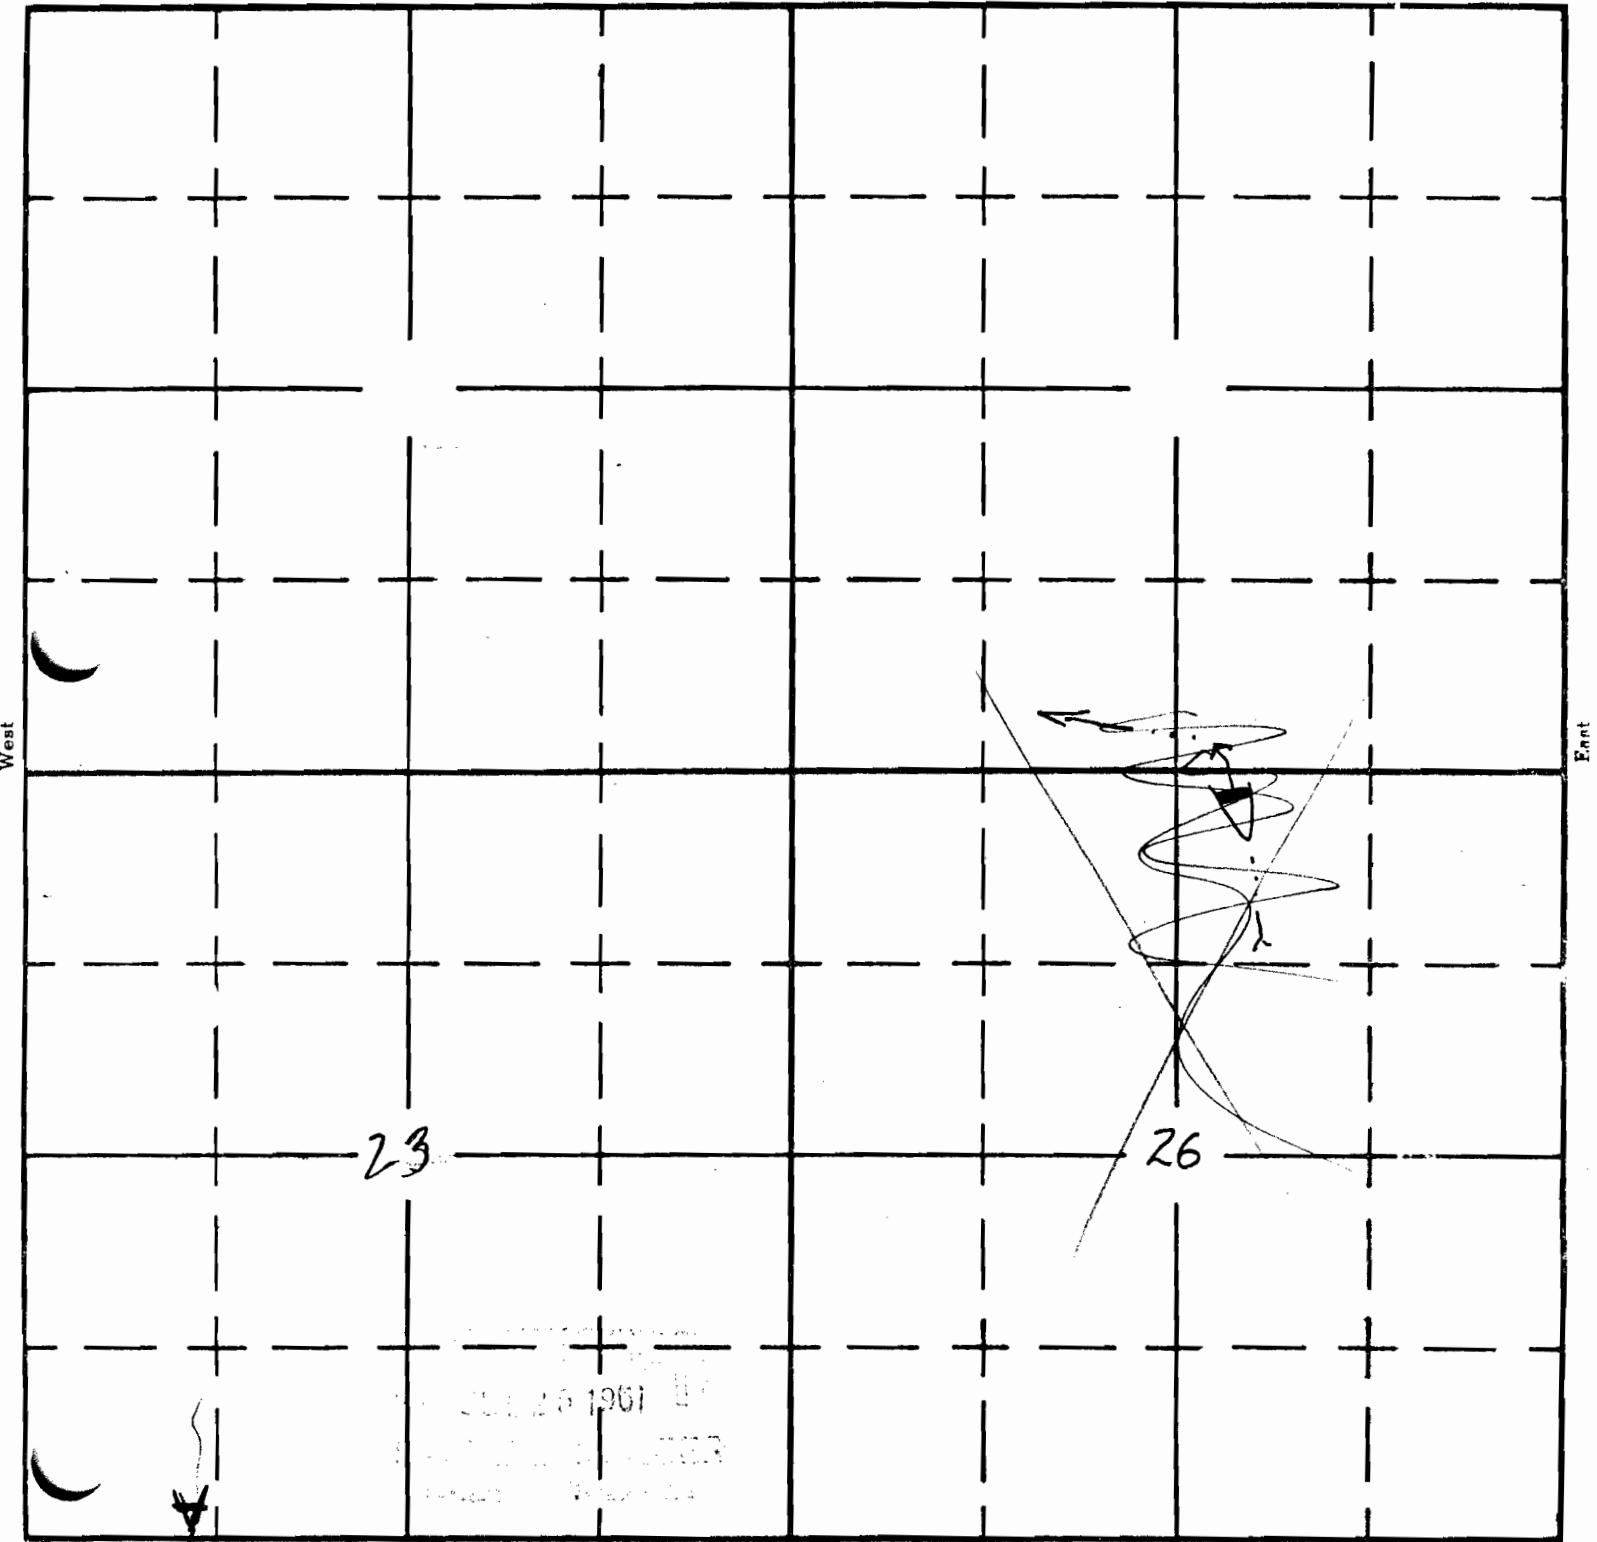

23

26

RECEIVED
JUL 26 1961
BUREAU OF LAND MANAGEMENT
WASHINGTON, D.C.

UNAPPLIED
Interior Drainage, Blitzen River System

APPLICATION No. R-35479
PERMIT No. R-4163