

Form A1-187
March 1961

UNITED STATES
DEPARTMENT OF THE INTERIOR
BUREAU OF LAND MANAGEMENT

SECTION


SE 1/4 NW 1/4

Sec. 22

Oregon State Water Filings

TOWNSHIP 30 S, RANGE 32 E, W. M.

North

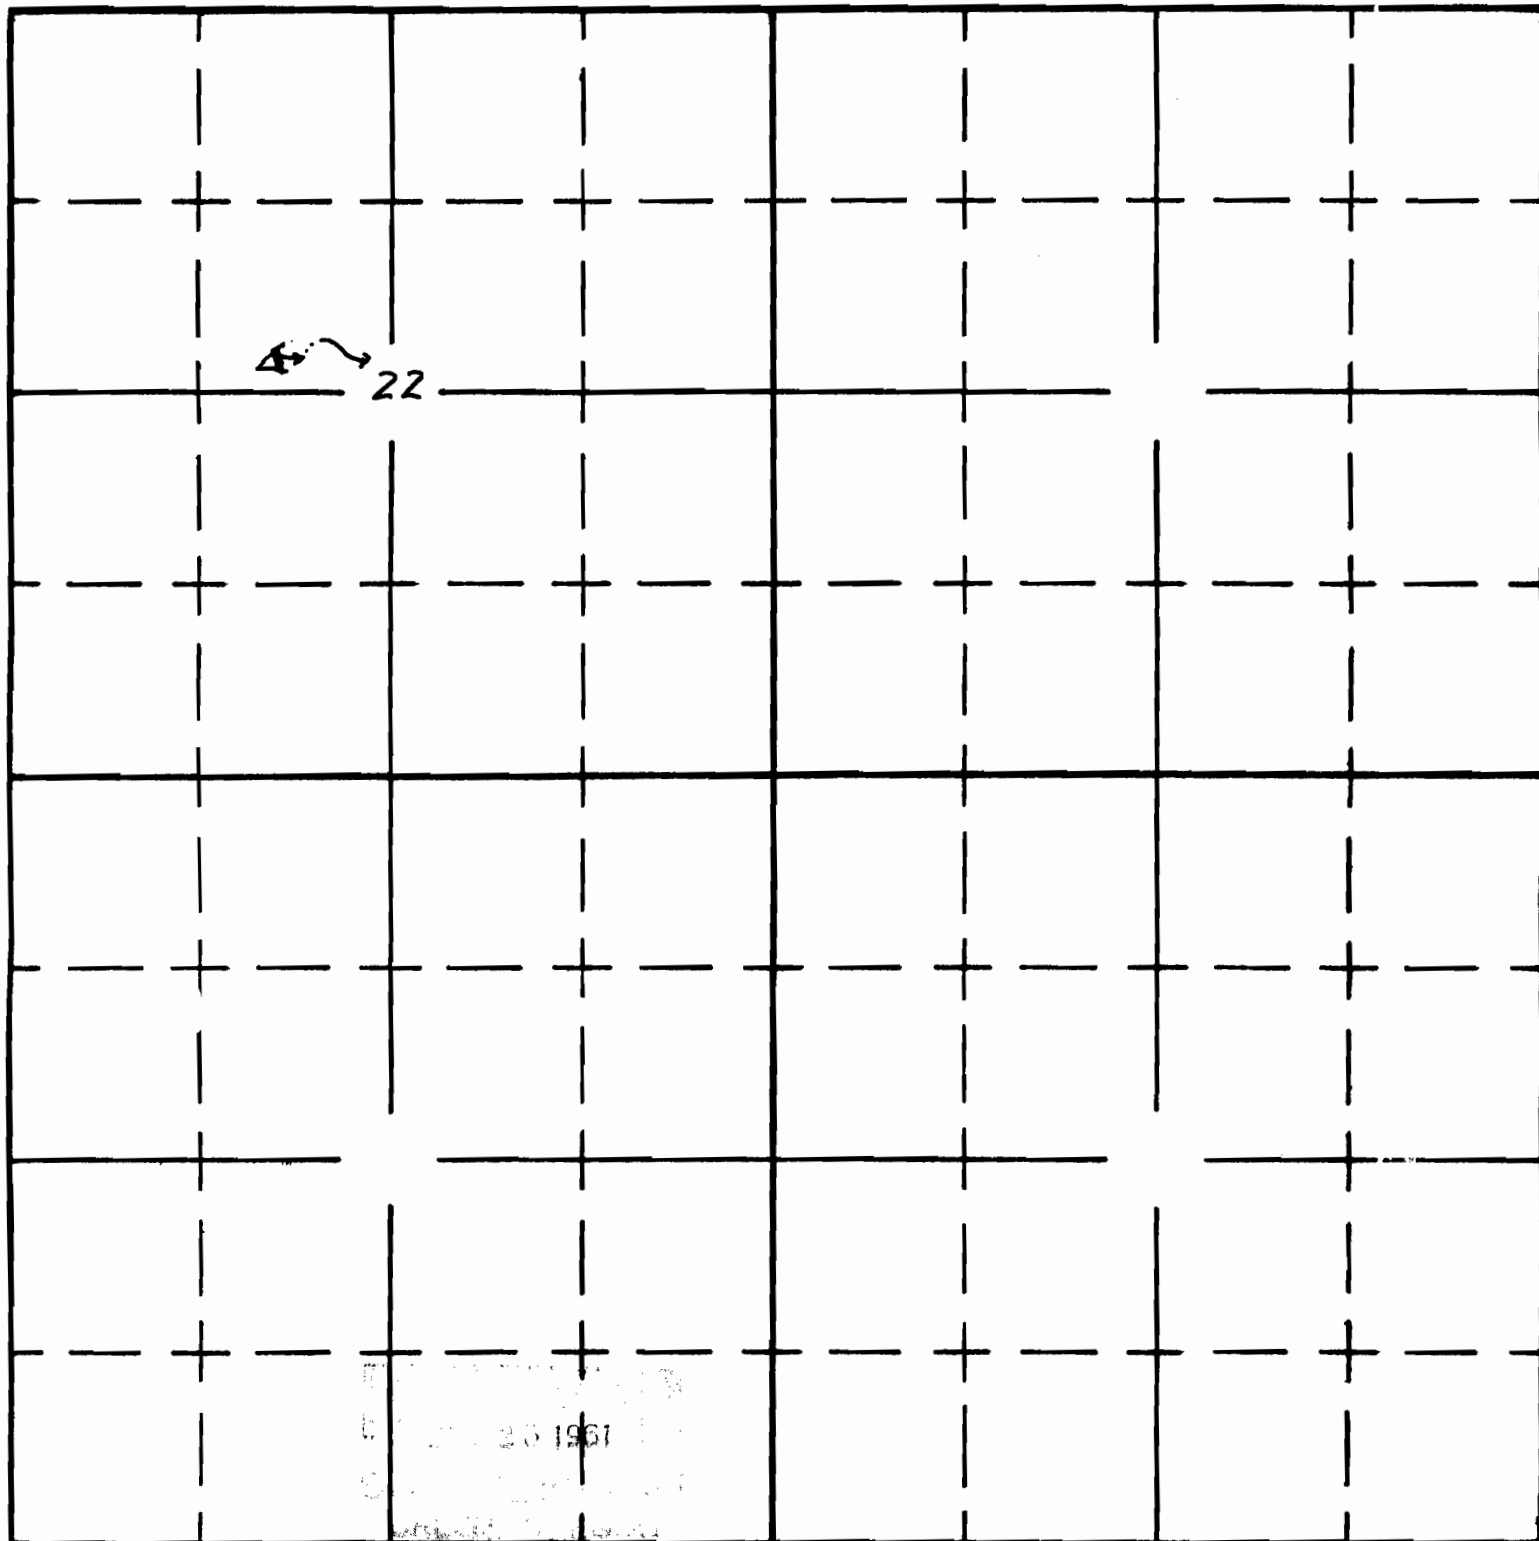

UNNAMED

South

Intersect drainage, McCoy Creek Drain

APPLICATION No. R-35481

PERMIT No. R-4165