


Form A1-187
March 1961

UNITED STATES
DEPARTMENT OF THE INTERIOR
BUREAU OF LAND MANAGEMENT

SECTION
SE $\frac{1}{4}$ NE $\frac{1}{4}$
SEC. 29

Oregon State Water Filings

TOWNSHIP 32 S, RANGE 32 $\frac{3}{4}$ E W. M.

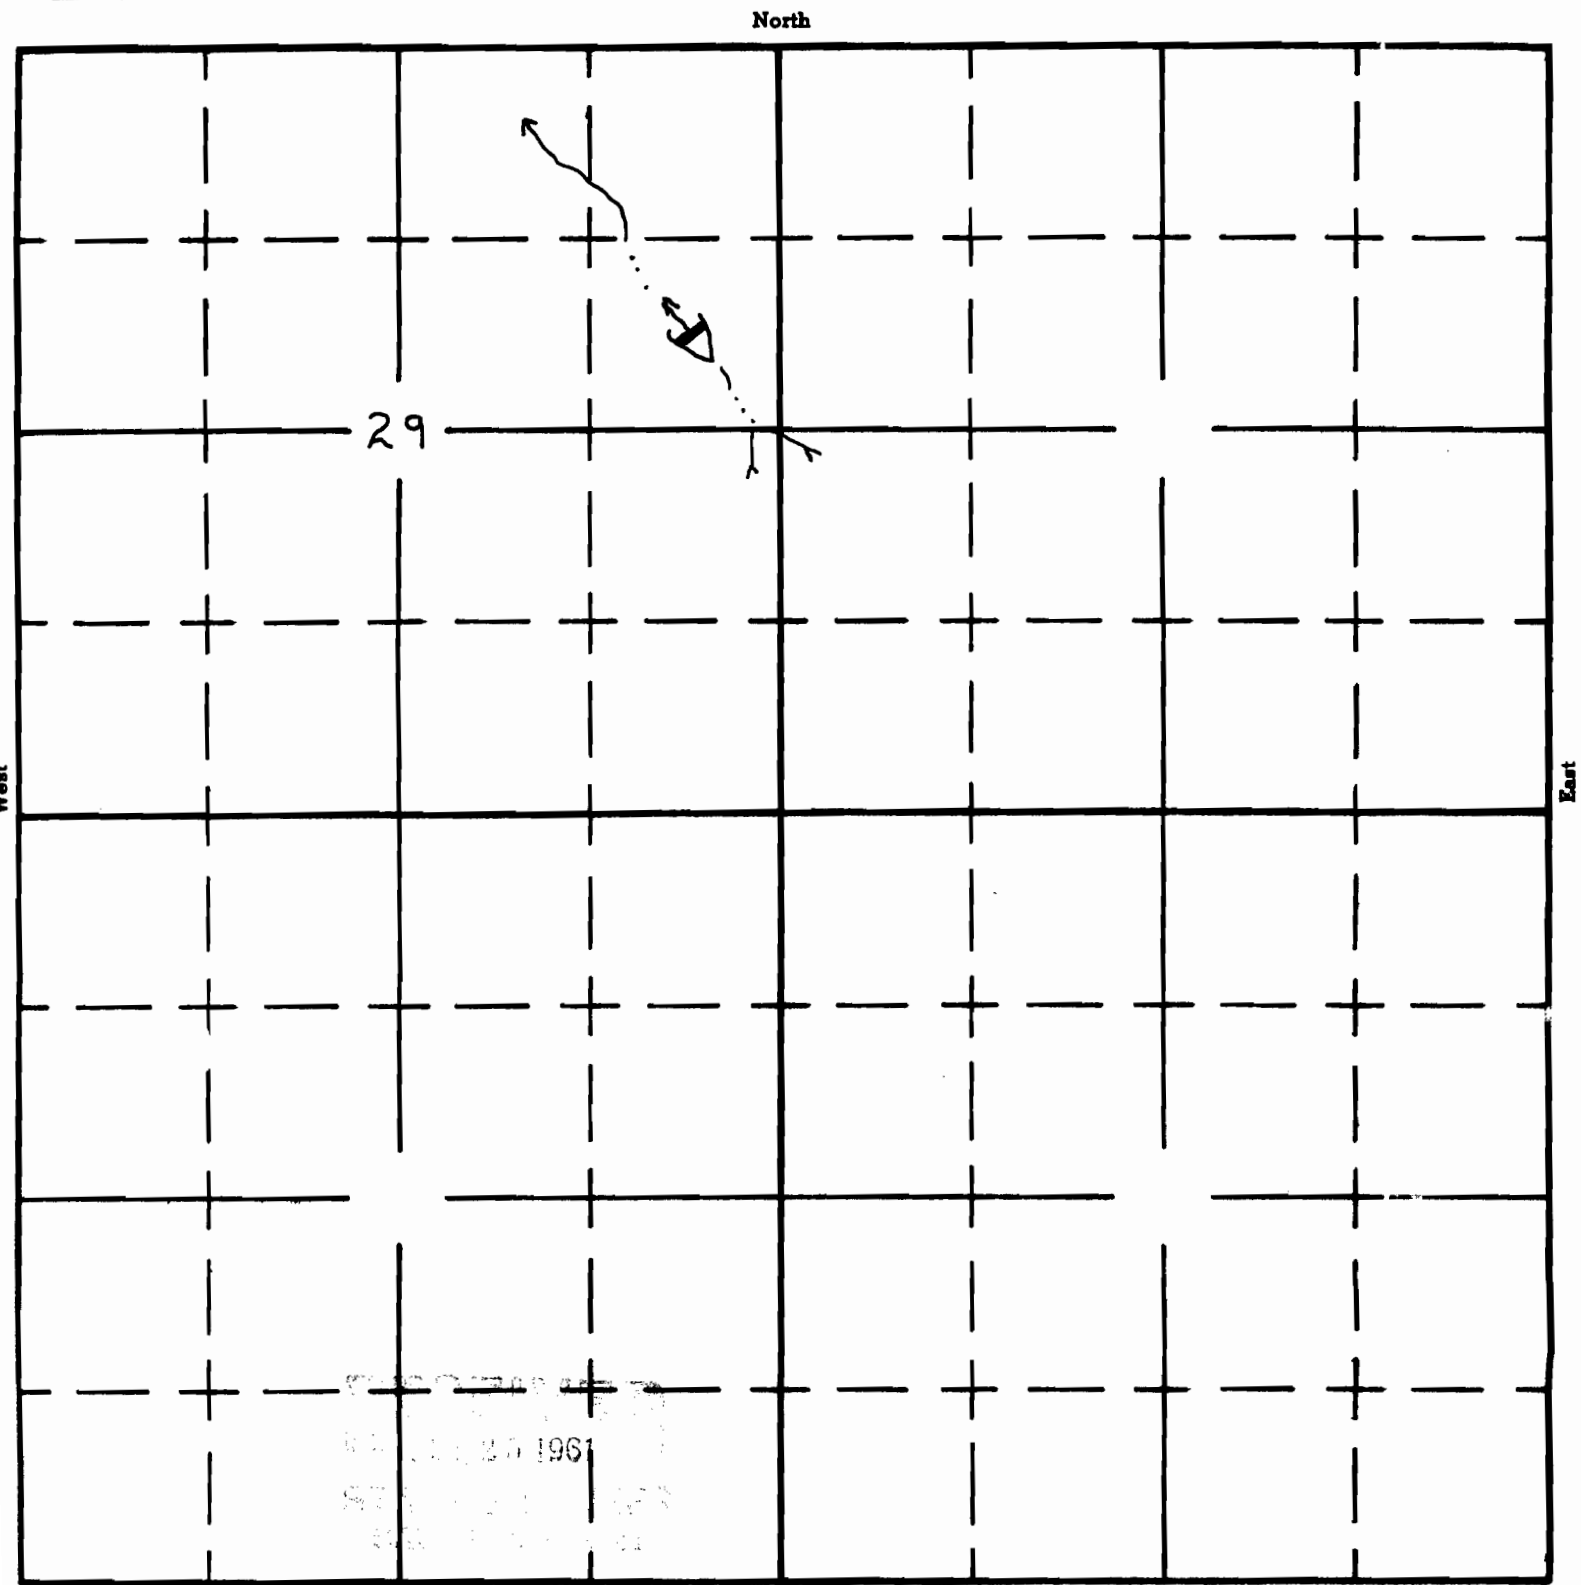

Unnamed
Rio Canyon Cr.

APPLICATION No. **R-35482**

PERMIT No. **R-4166**