

Form A1-187  
March 1961

UNITED STATES  
DEPARTMENT OF THE INTERIOR  
BUREAU OF LAND MANAGEMENT

SECTION


SE  $\frac{1}{4}$  SE  $\frac{1}{4}$

# Oregon State Water Filings

SEC. 24

TOWNSHIP 32 S, RANGE 32  $\frac{1}{2}$  E W. M.

North

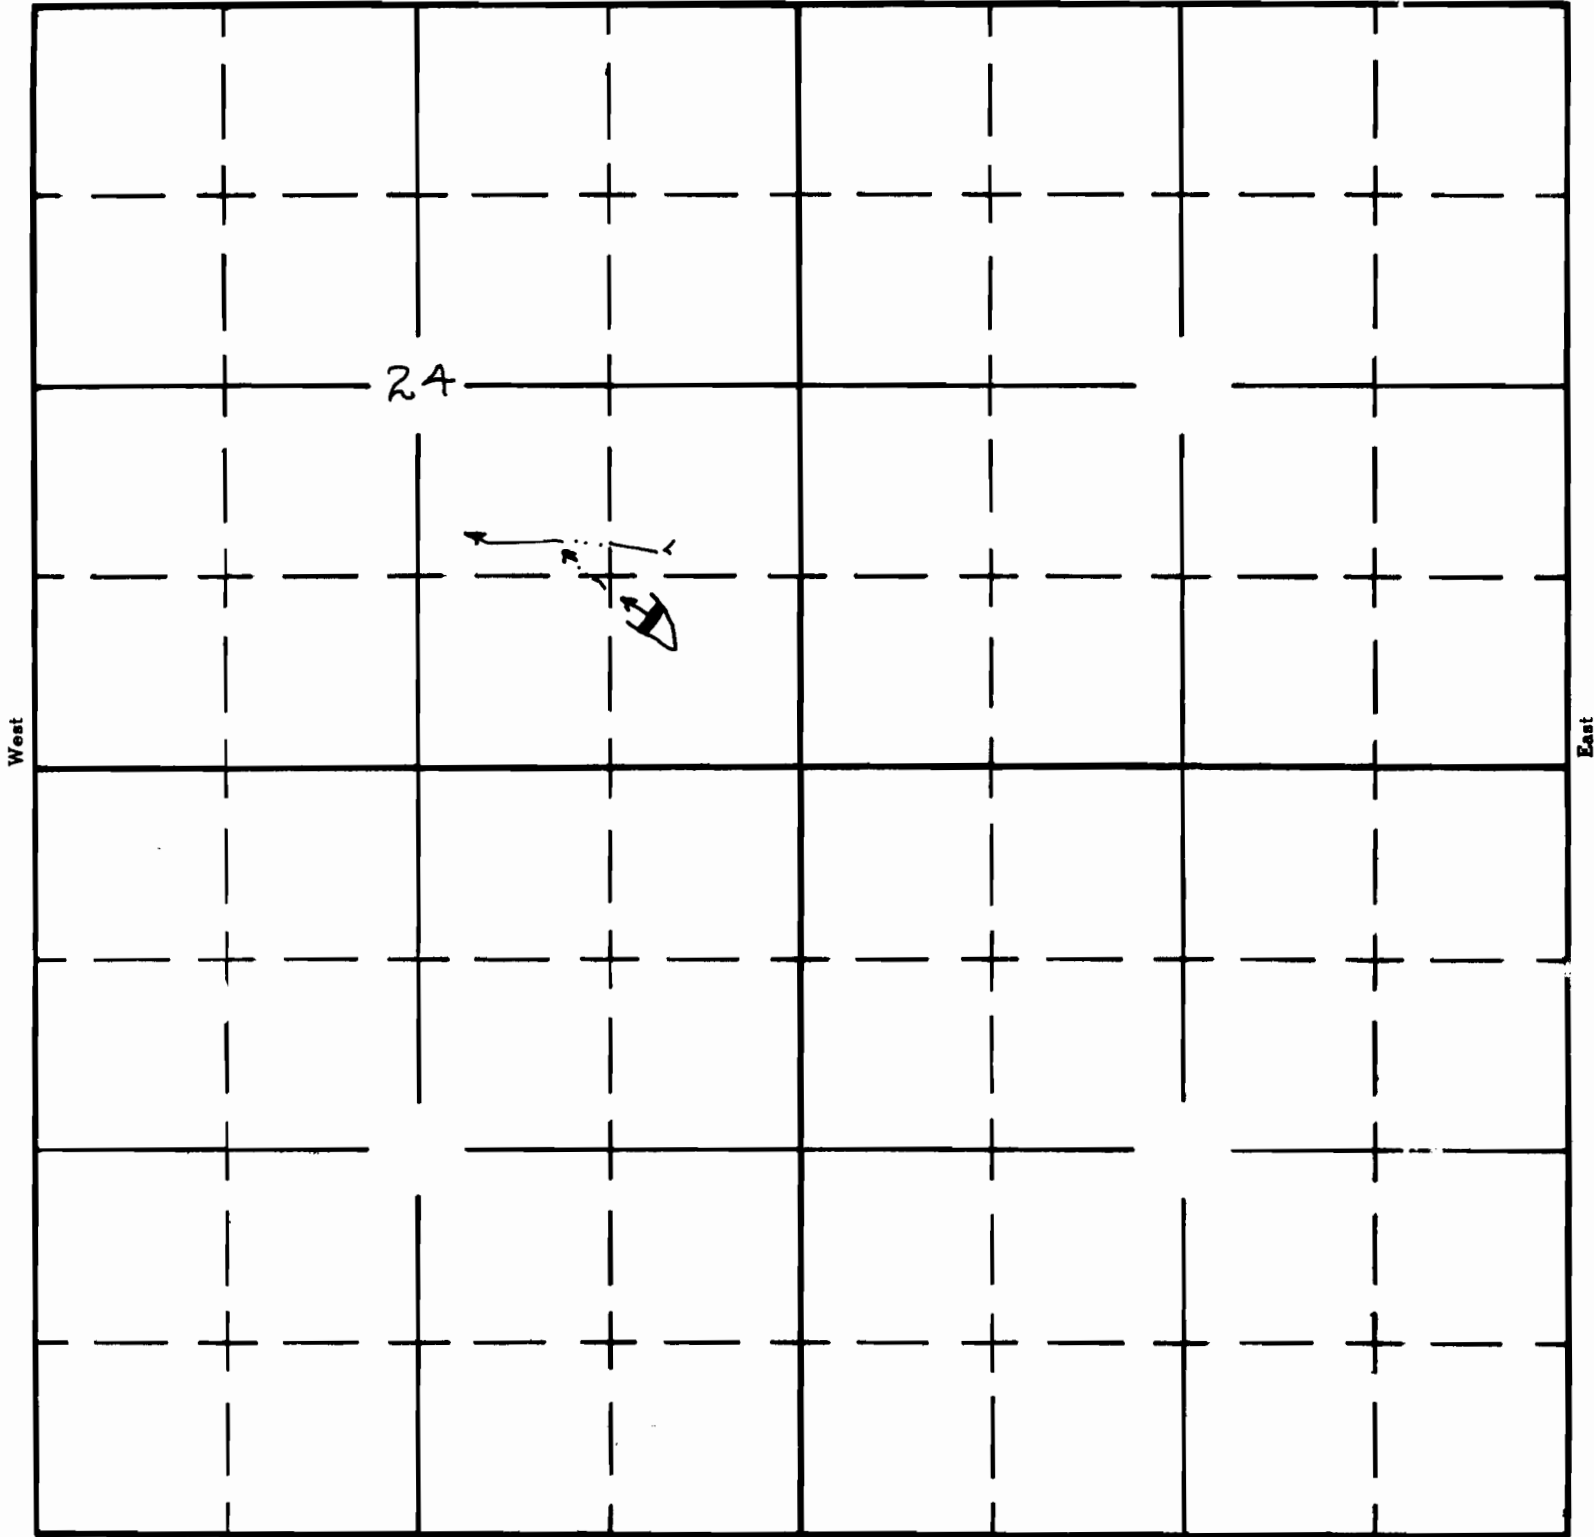

*Unsubstantiated*

South

APPLICATION No. **R-35484**  
PERMIT No. **R-4168**