

UNITED STATES
DEPARTMENT OF THE INTERIOR
BUREAU OF LAND MANAGEMENT

SECTION


Oregon State Water Filings

NW 1/4 SE 1/4

TOWNSHIP 41 S, RANGE 37 E, W. M.

10

North

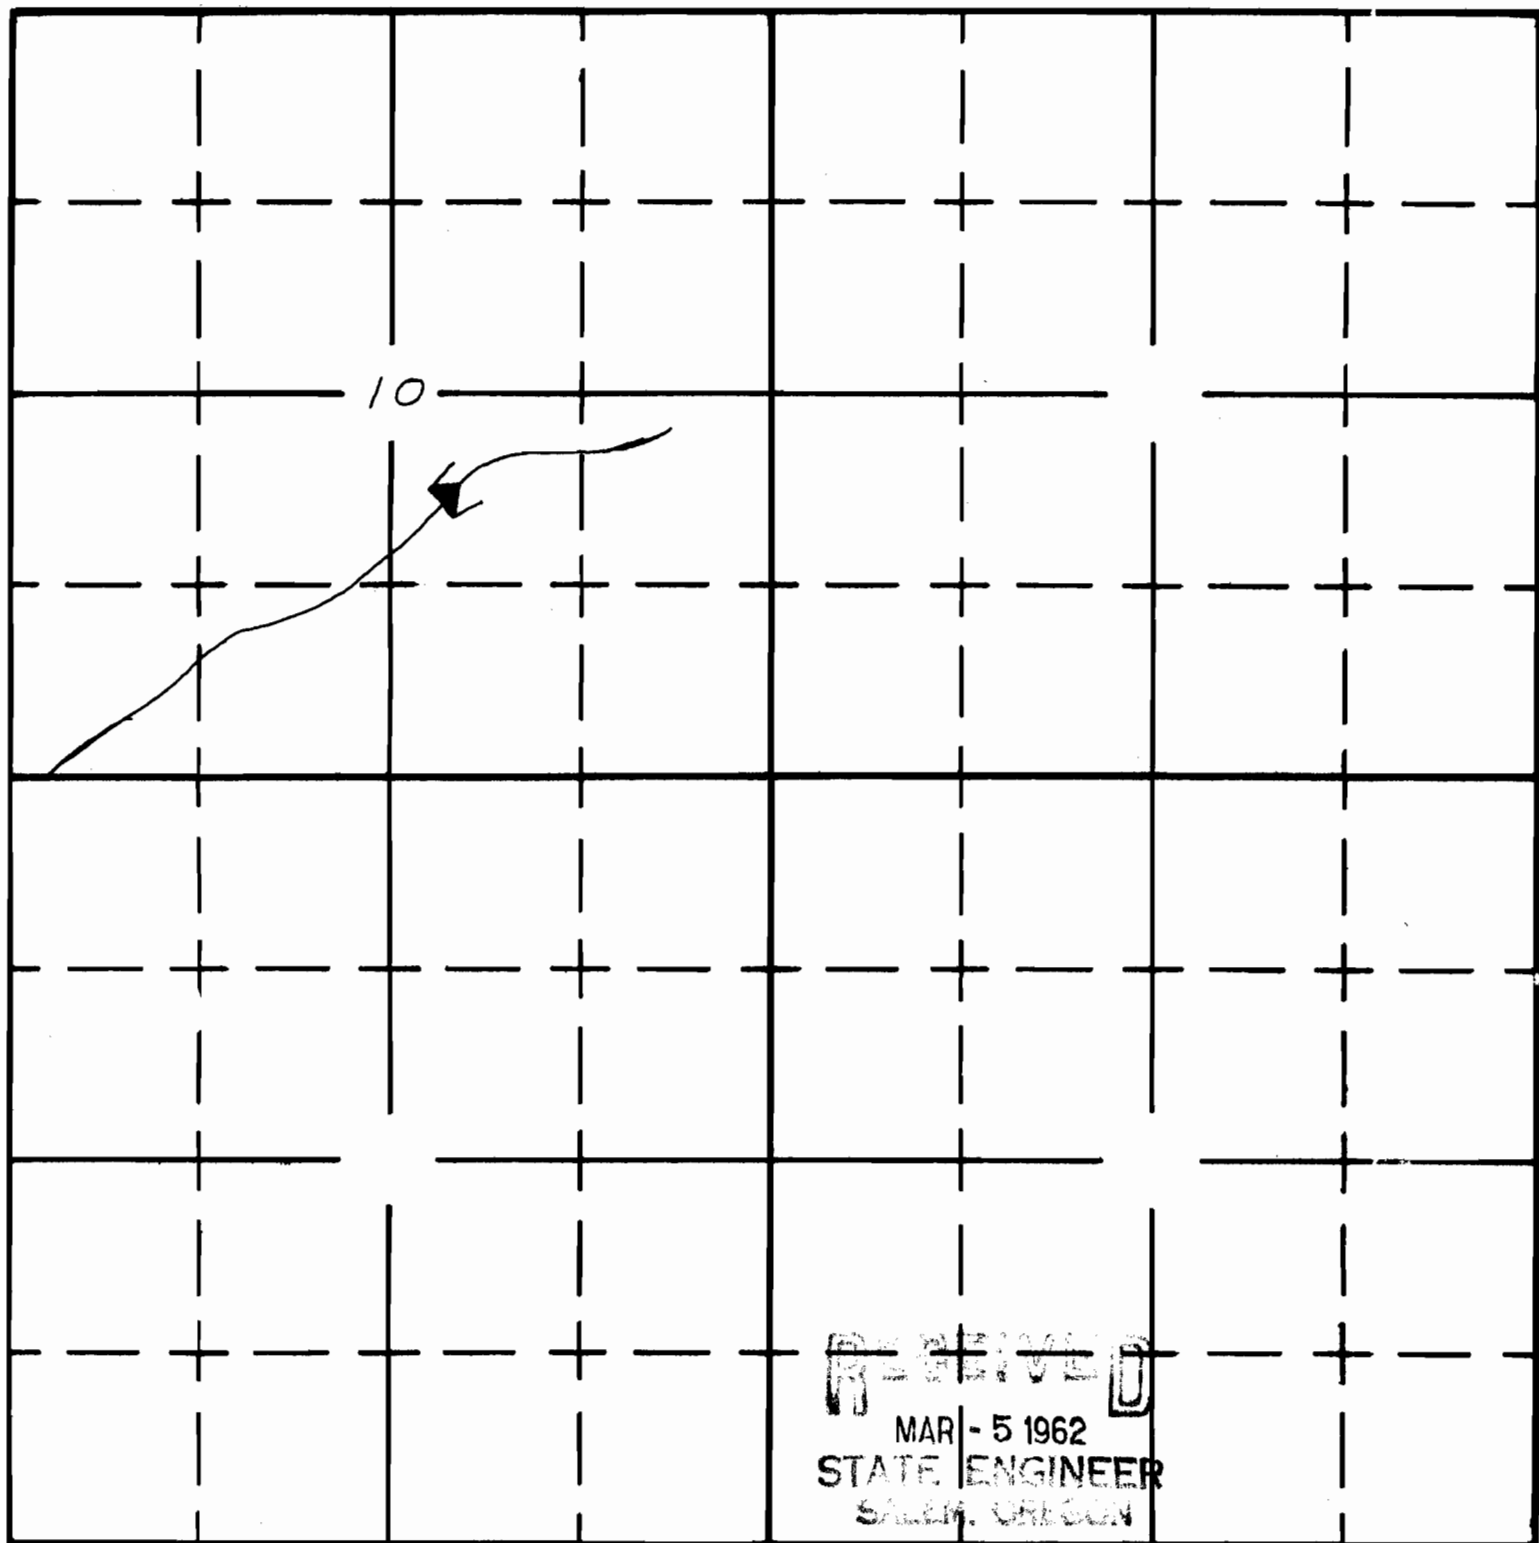

South

APPLICATION No. R-35496
PERMIT No. R-4176