


UNITED STATES
DEPARTMENT OF THE INTERIOR
BUREAU OF LAND MANAGEMENT

SECTION SE 1/4 NW 1/4
SEC 10

Oregon State Water Filings

TOWNSHIP 41 S, RANGE 38 E, W. M.

North

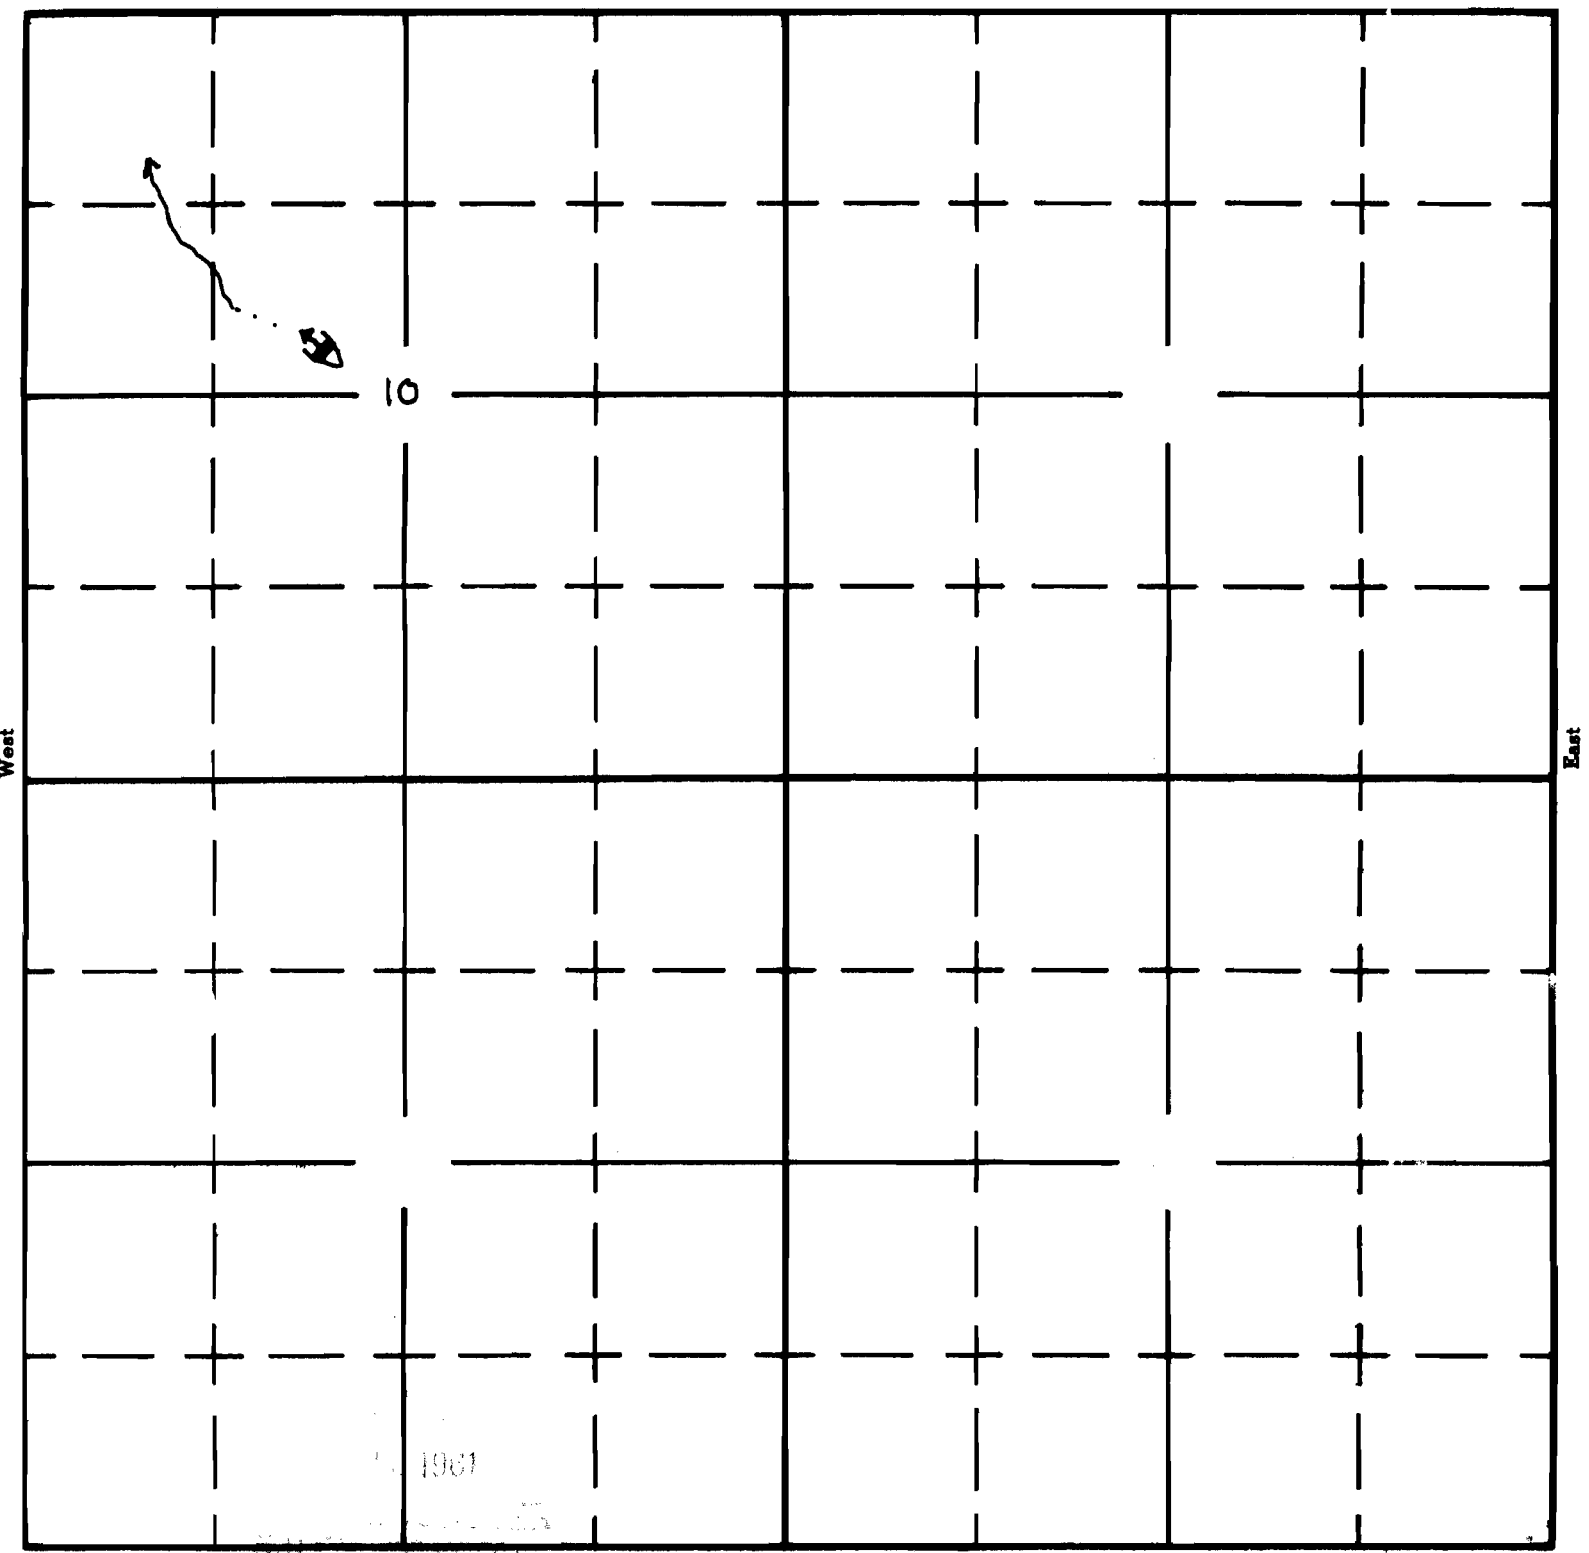

UNNAMED

South

E. Fork Trout cr.

APPLICATION No. R-35500

PERMIT No. R-4180