

Form A1-187
March 1961

UNITED STATES
DEPARTMENT OF THE INTERIOR
BUREAU OF LAND MANAGEMENT

SECTION


NW 1/4 SW 1/4

Oregon State Water Filings

Sec. 9

TOWNSHIP 41 S, RANGE 38 E, W. M.

North

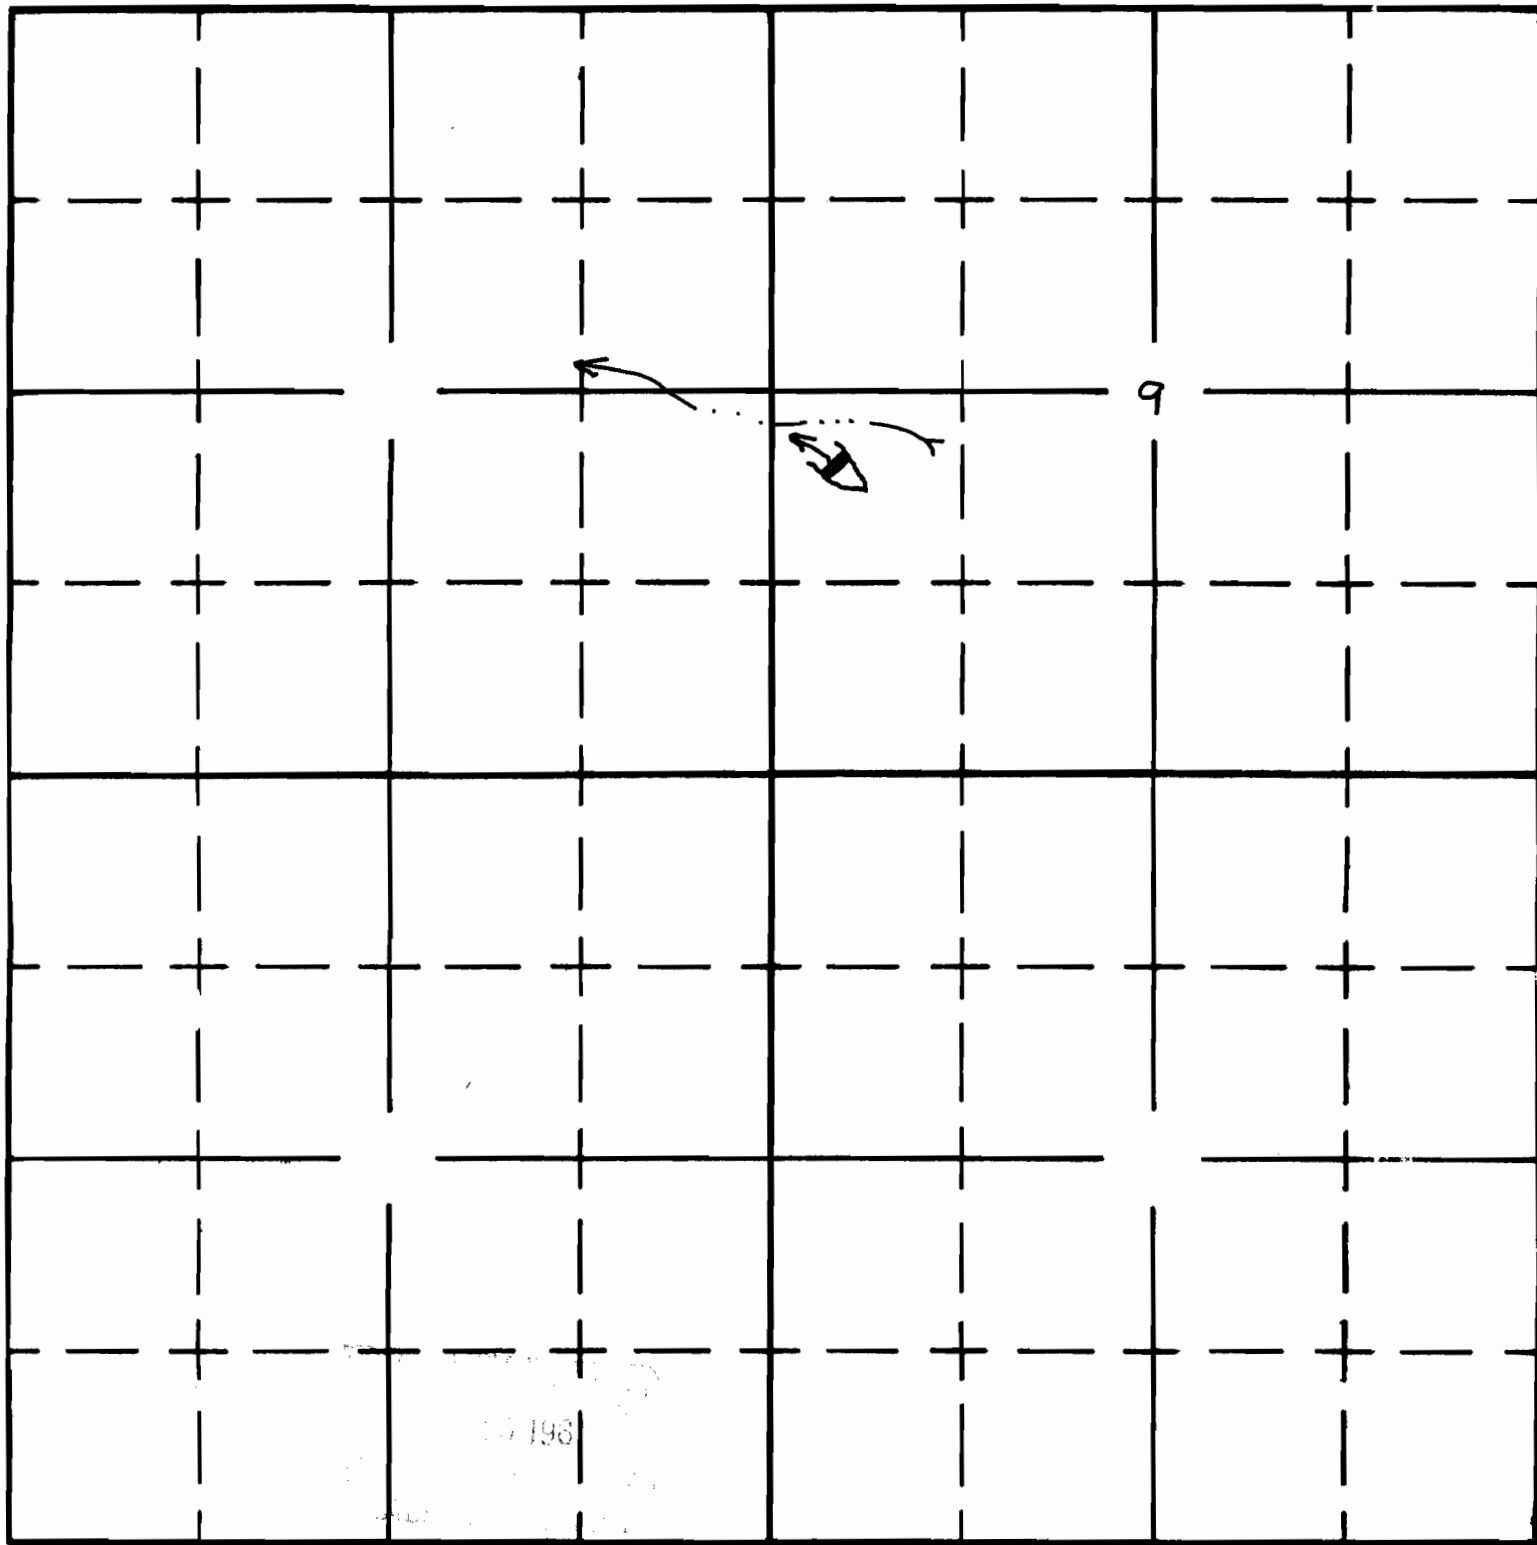

UNNAMED

South

Trout Cr.

APPLICATION No. R-35501

PERMIT No. R-4181