

UNITED STATES
DEPARTMENT OF THE INTERIOR
BUREAU OF LAND MANAGEMENT

SECTION


SE $\frac{1}{4}$ SE $\frac{1}{4}$

Oregon State Water Filings

SEC. 11

TOWNSHIP 32 S., RANGE 32 $\frac{1}{2}$ E. W. M.

North

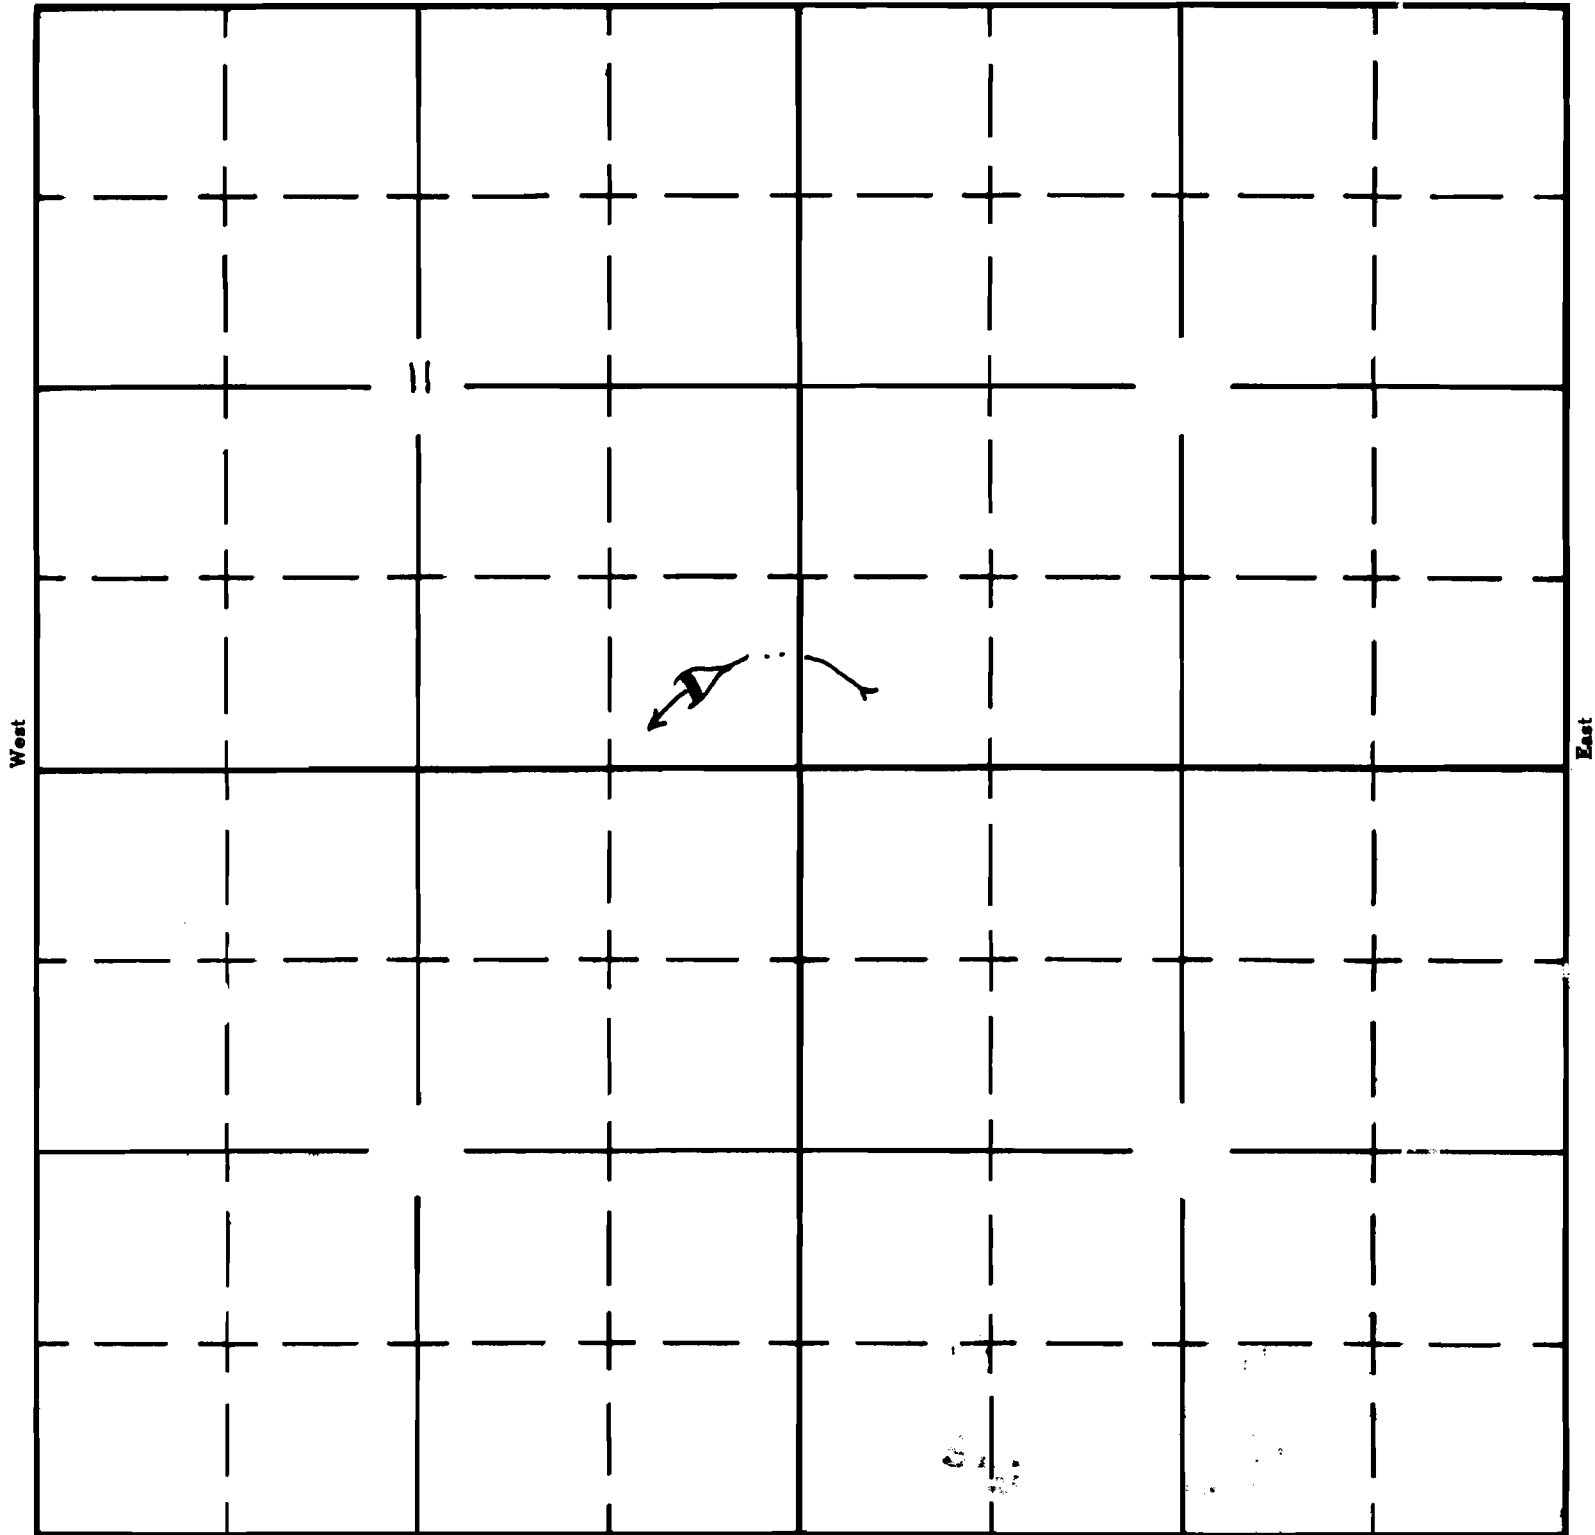

South

APPLICATION No. R-35672
PERMIT No. R-4192