

Form A1-187
March 1961

UNITED STATES
DEPARTMENT OF THE INTERIOR
BUREAU OF LAND MANAGEMENT


SECTION

Oregon State Water Filings

NE 1/4 NW 1/4

TOWNSHIP 31, RANGE 32 3/4 W. M.

Sec. 26

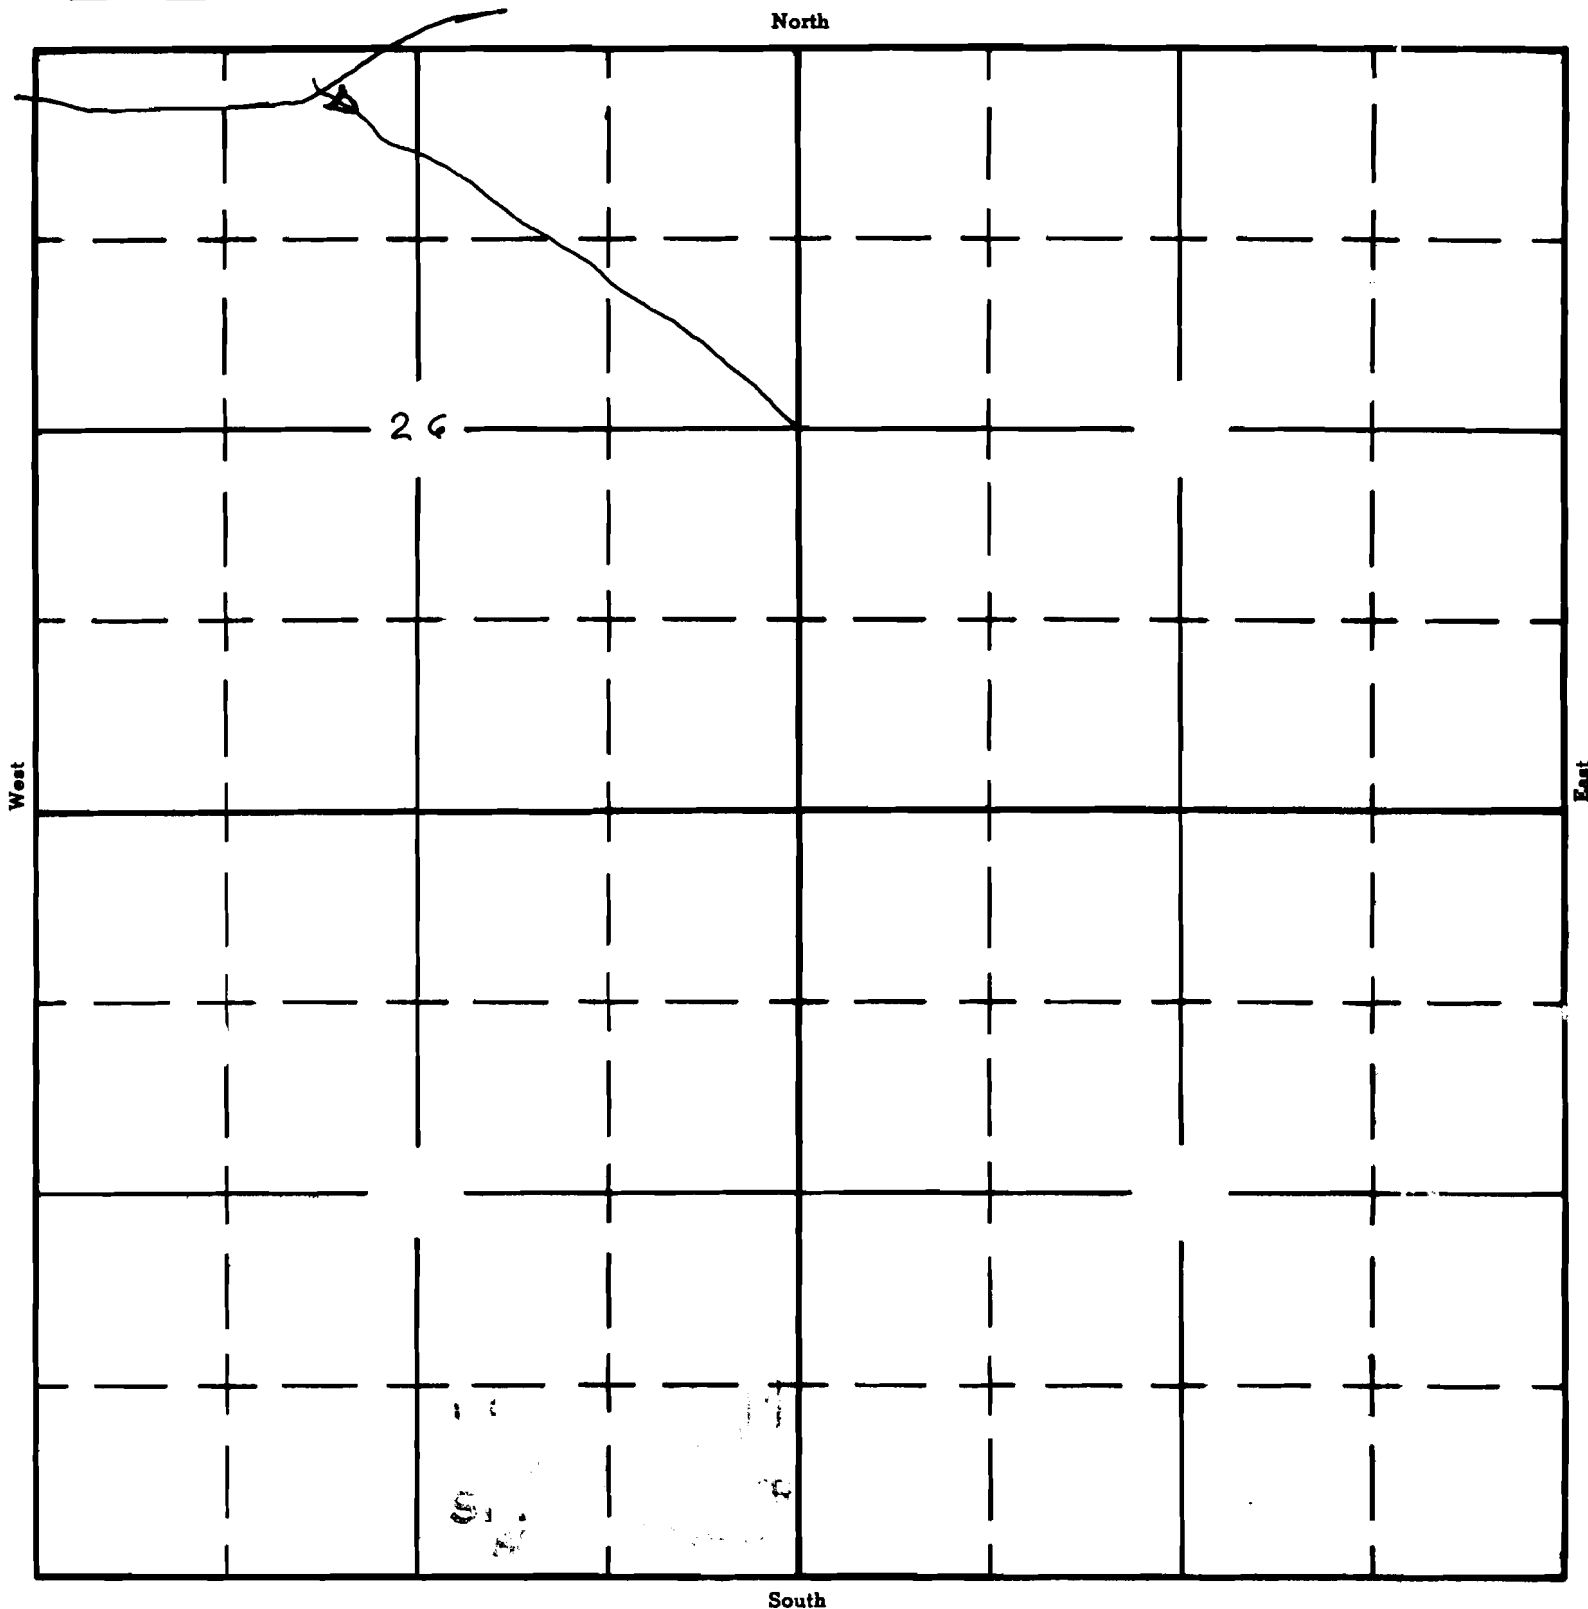

APPLICATION No. R-35684
PERMIT No. R-4199