

UNITED STATES
DEPARTMENT OF THE INTERIOR
BUREAU OF LAND MANAGEMENT

SECTION


SW 1/4 NW 1/4

Oregon State Water Filings

2

TOWNSHIP 32 S RANGE 32 1/4, W. M.

North

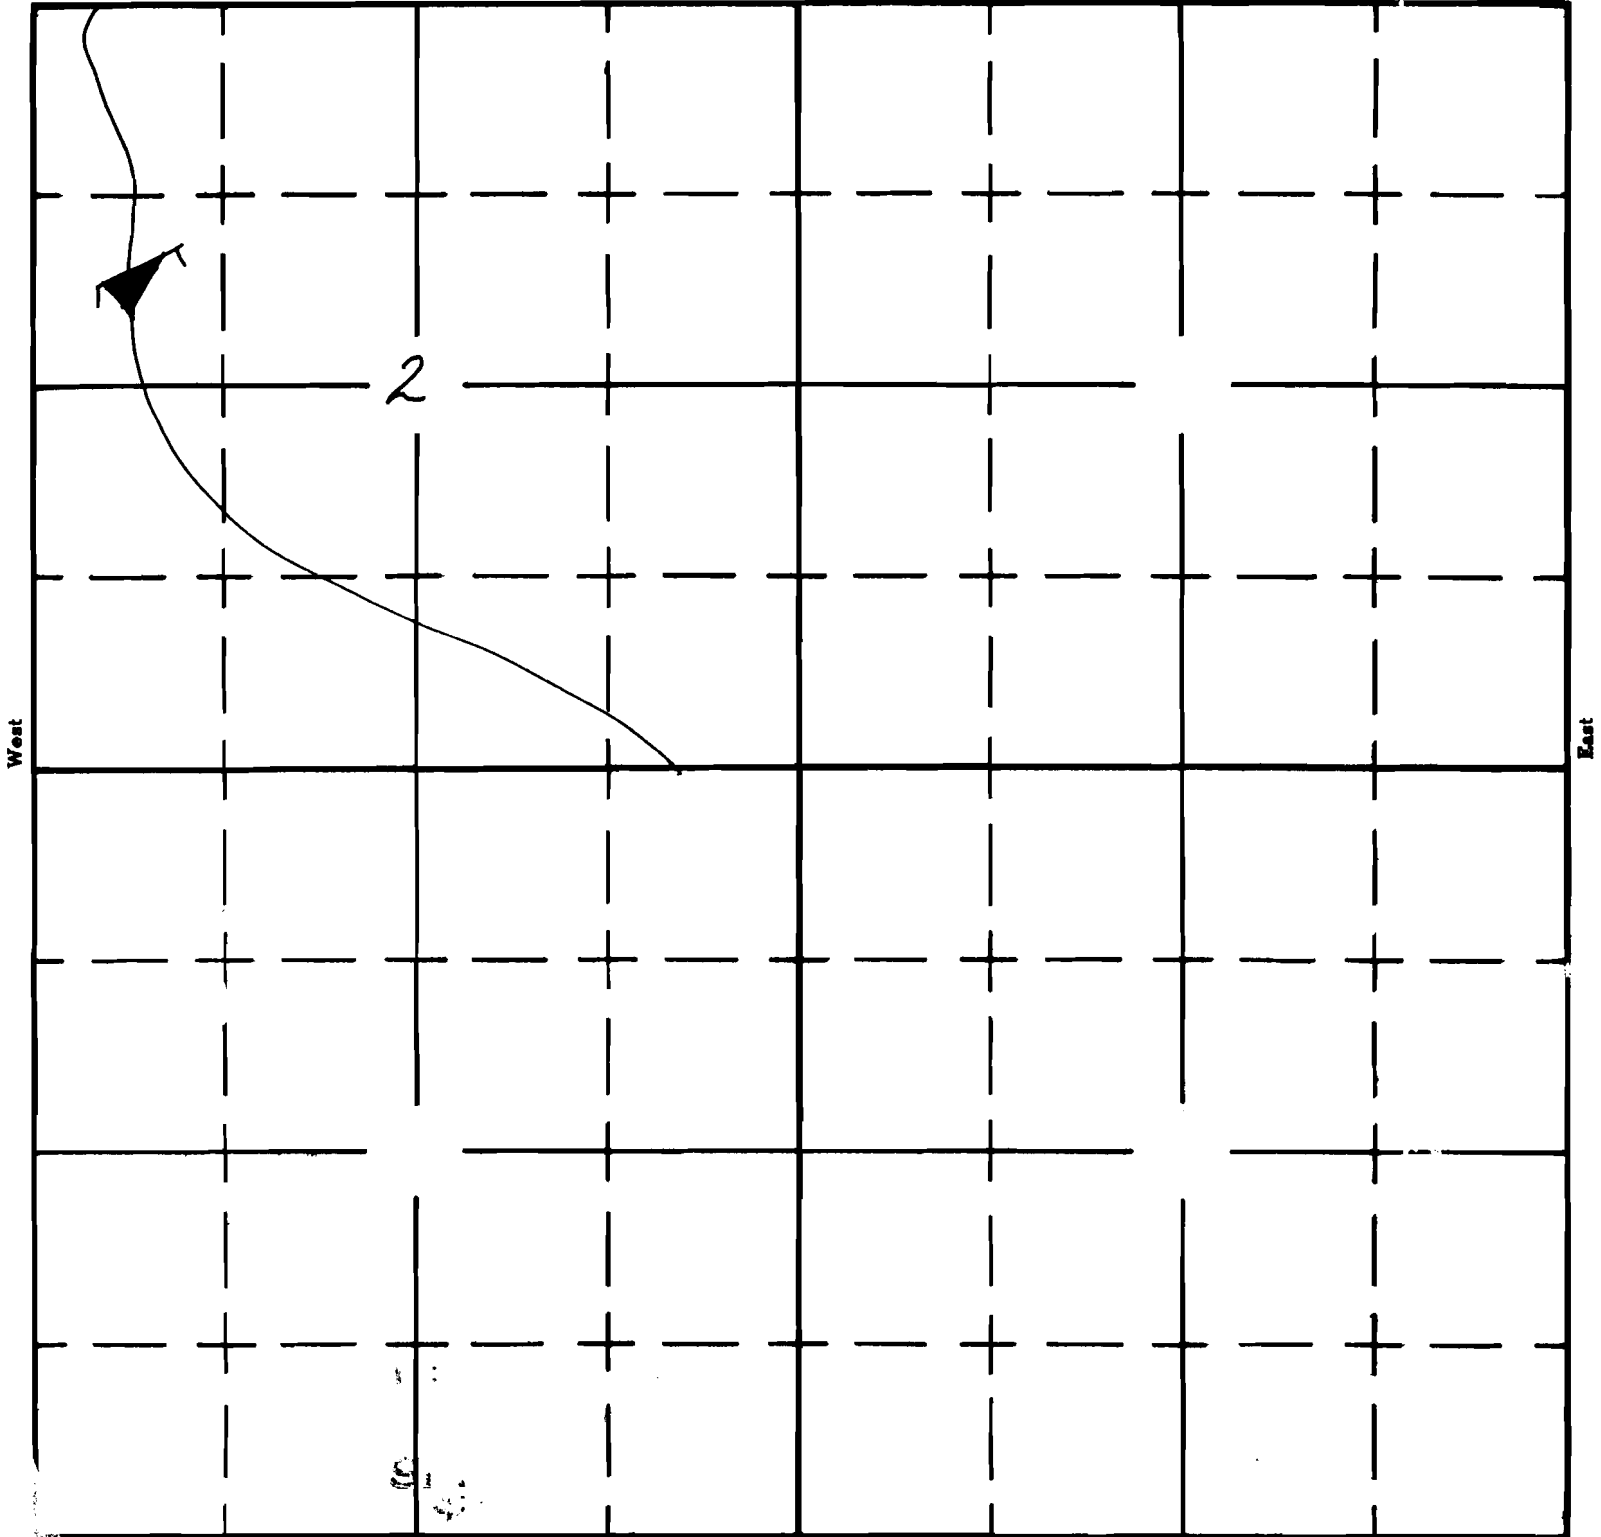

South

APPLICATION No. R-35695
PERMIT No. R-4201