

Form AI-187
March 1961

UNITED STATES
DEPARTMENT OF THE INTERIOR
BUREAU OF LAND MANAGEMENT

SECTION

SW 1/4 SE 1/4

30


NW 1/4 NE 1/4

31

Oregon State Water Filings

TOWNSHIP 22S, RANGE 28E, W. M.

North

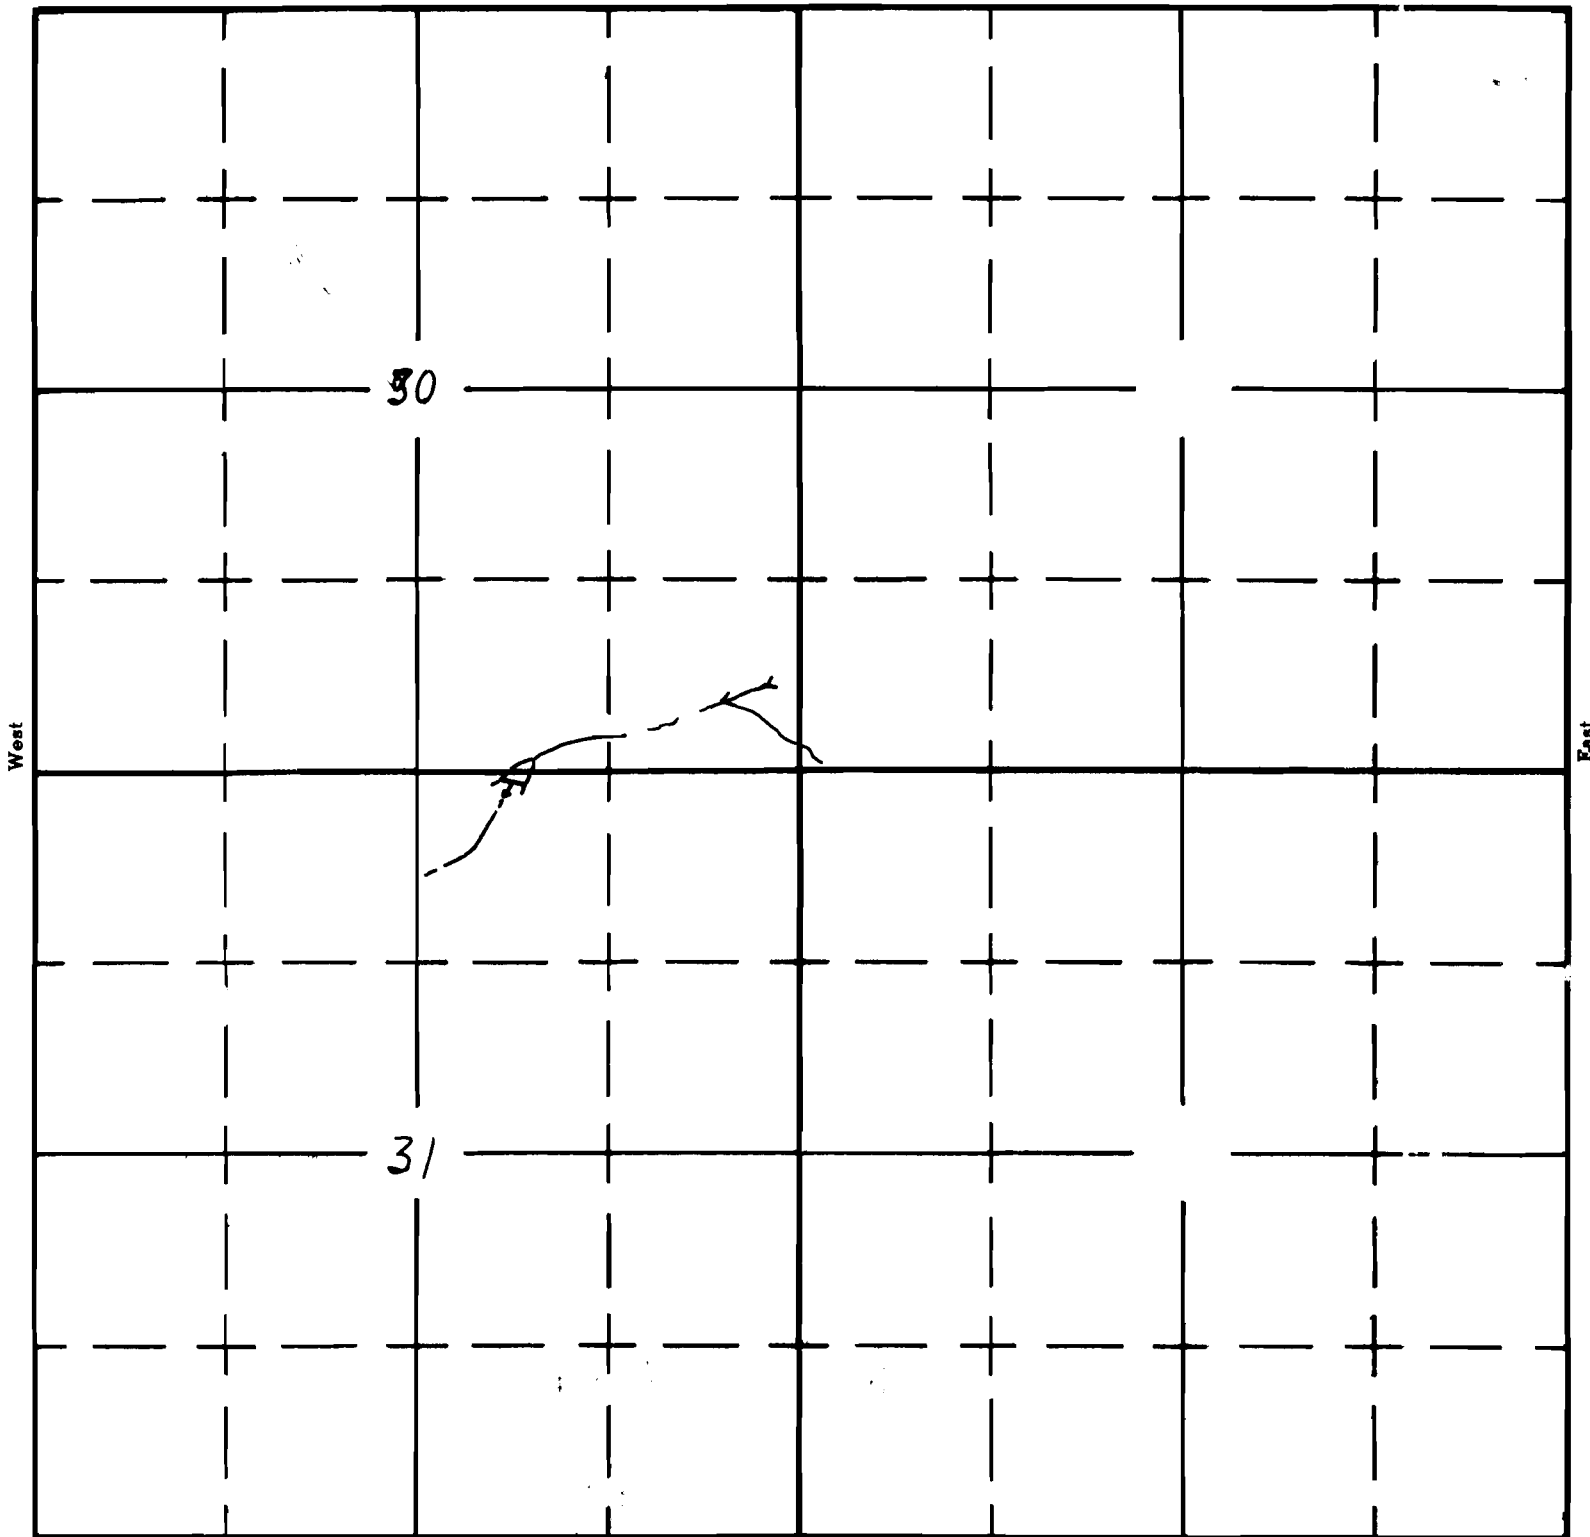

South

APPLICATION No. R-35609
PERMIT No. R 6702