

Form AI-187
March 1961

UNITED STATES
DEPARTMENT OF THE INTERIOR
BUREAU OF LAND MANAGEMENT

SECTION


SE $\frac{1}{4}$ SW $\frac{1}{4}$

Oregon State Water Filings

SEC. 17

TOWNSHIP 23 S, RANGE 28 E, W. M.

North

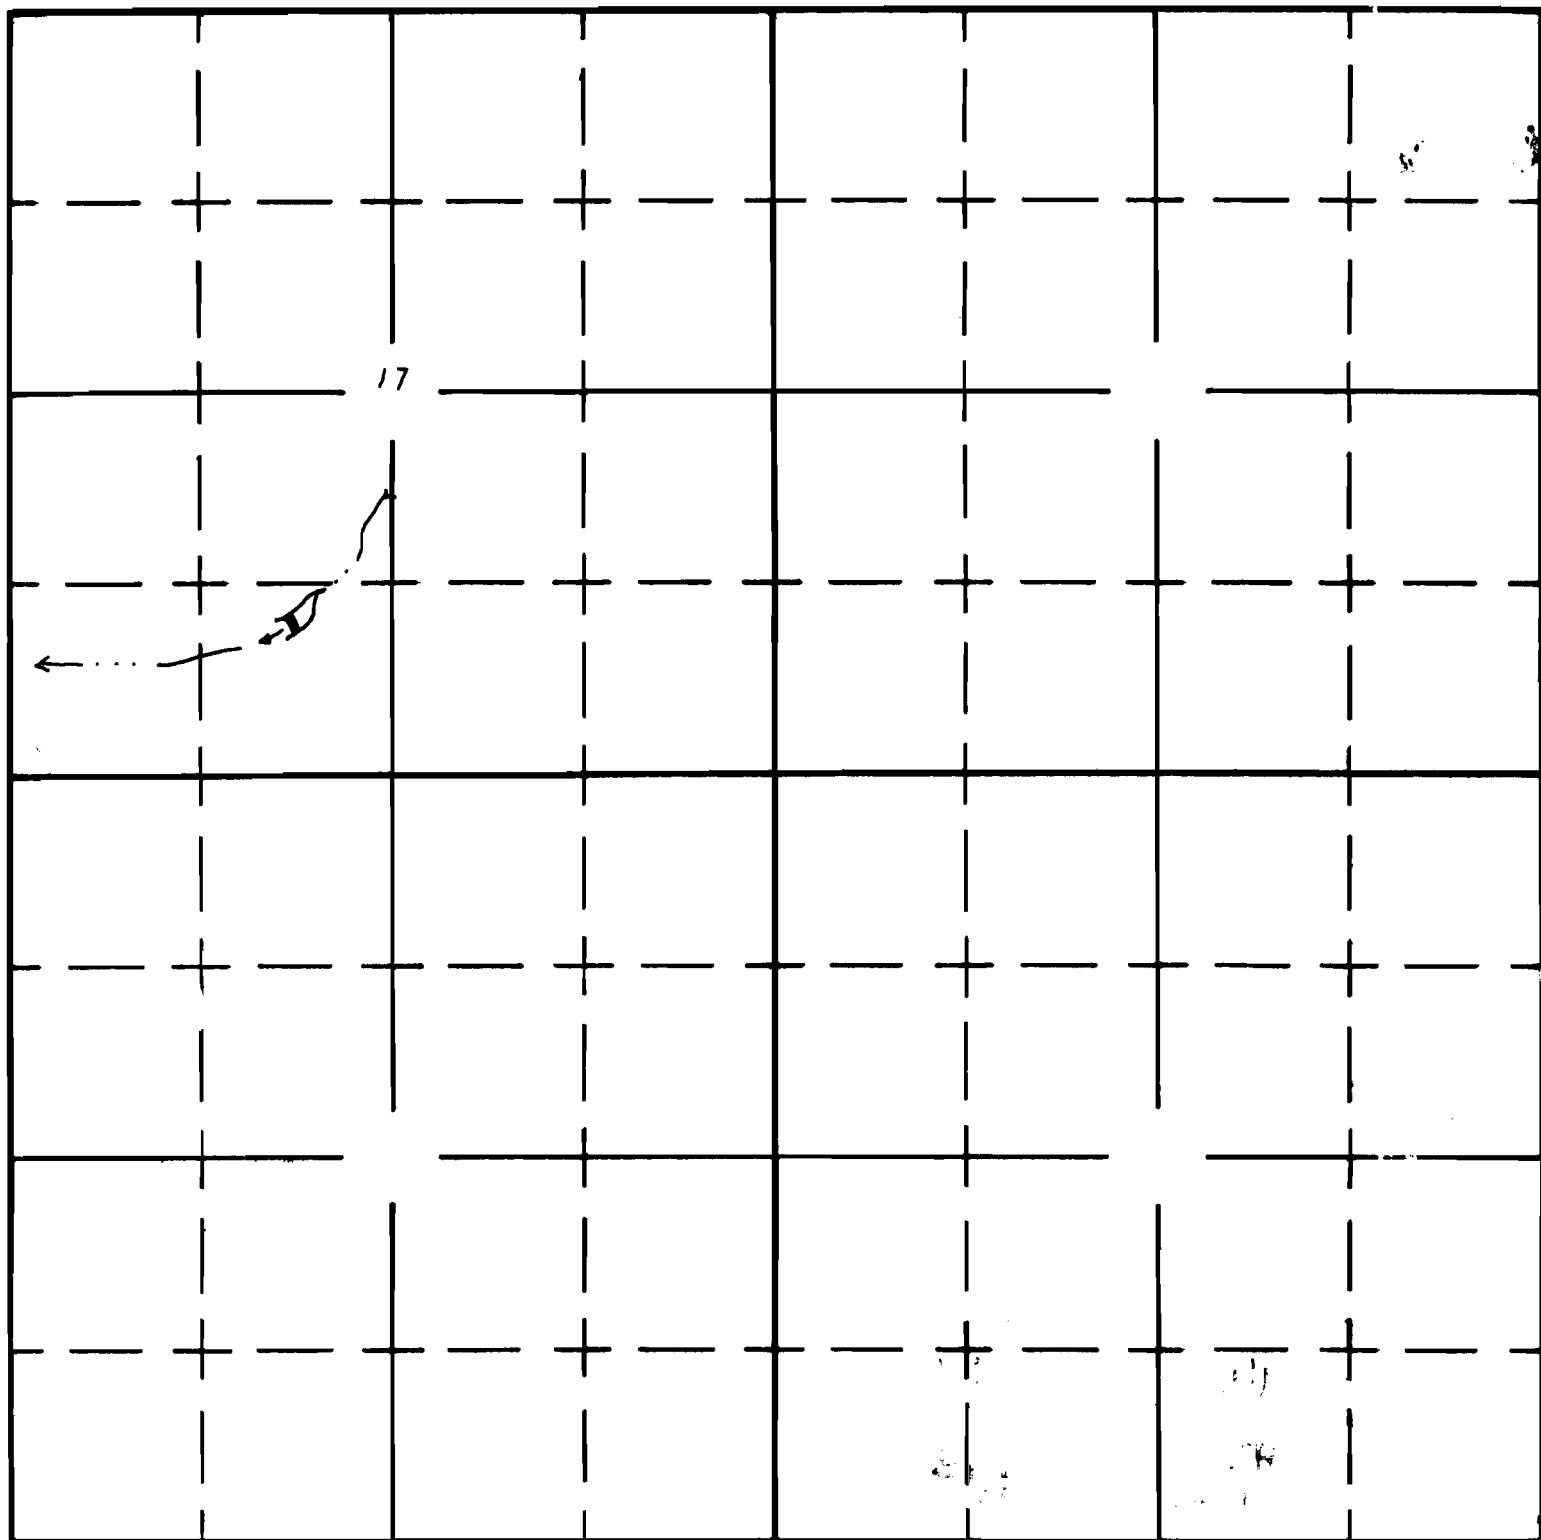

South

APPLICATION No. R-35643

PERMIT No. R 6809