


UNITED STATES
DEPARTMENT OF THE INTERIOR
BUREAU OF LAND MANAGEMENT

SECTION
SW $\frac{1}{4}$ SW $\frac{1}{4}$
SEC. 22

Oregon State Water Filings

TOWNSHIP 22 S, RANGE 27 E, W. M.

North

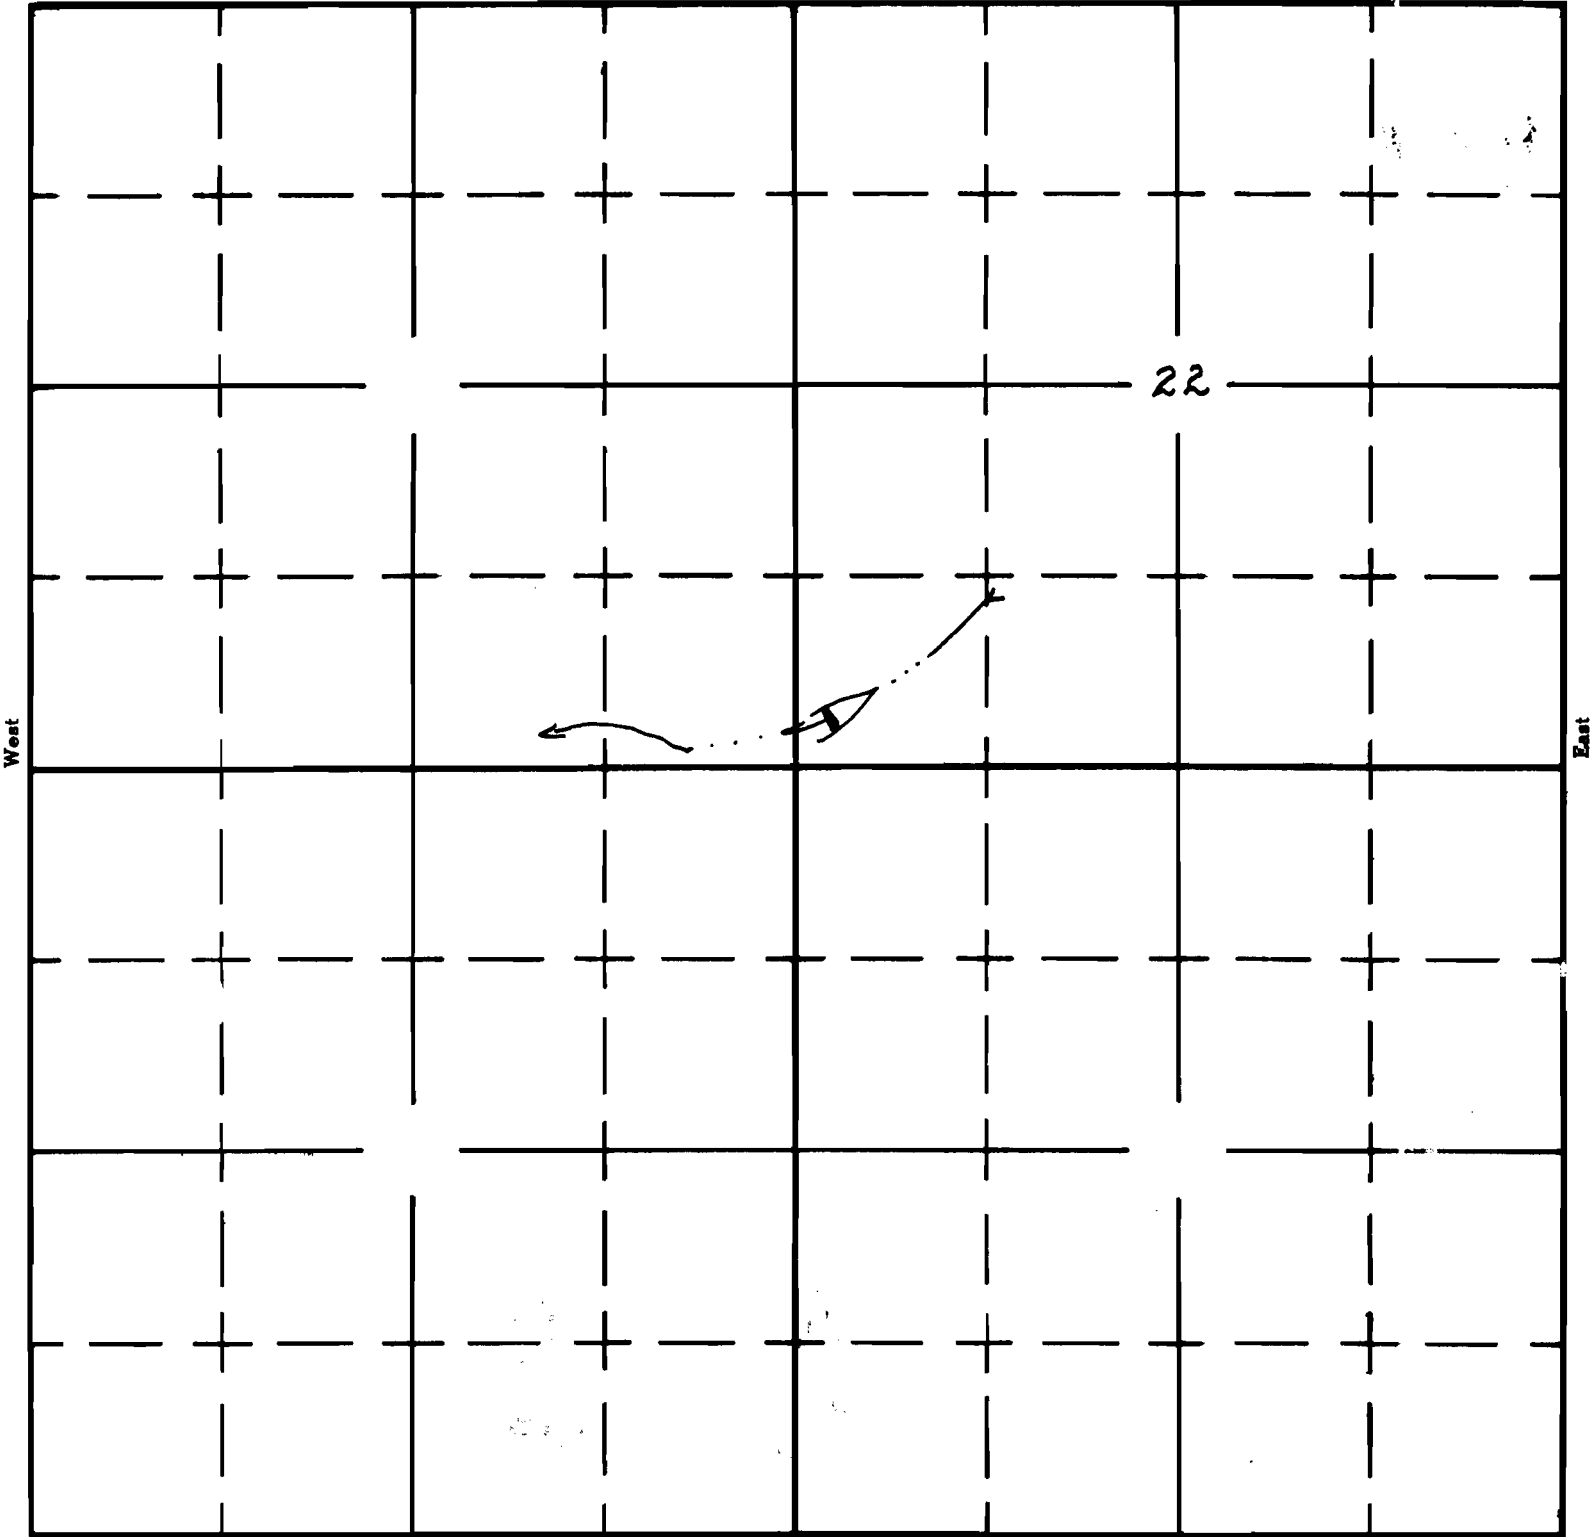

South