


Form AI-187
March 1961

UNITED STATES
DEPARTMENT OF THE INTERIOR
BUREAU OF LAND MANAGEMENT

SECTION
N $\frac{1}{2}$ SE $\frac{1}{2}$
SEC 31

Oregon State Water Filings

TOWNSHIP 30S, RANGE 33E, W. M.

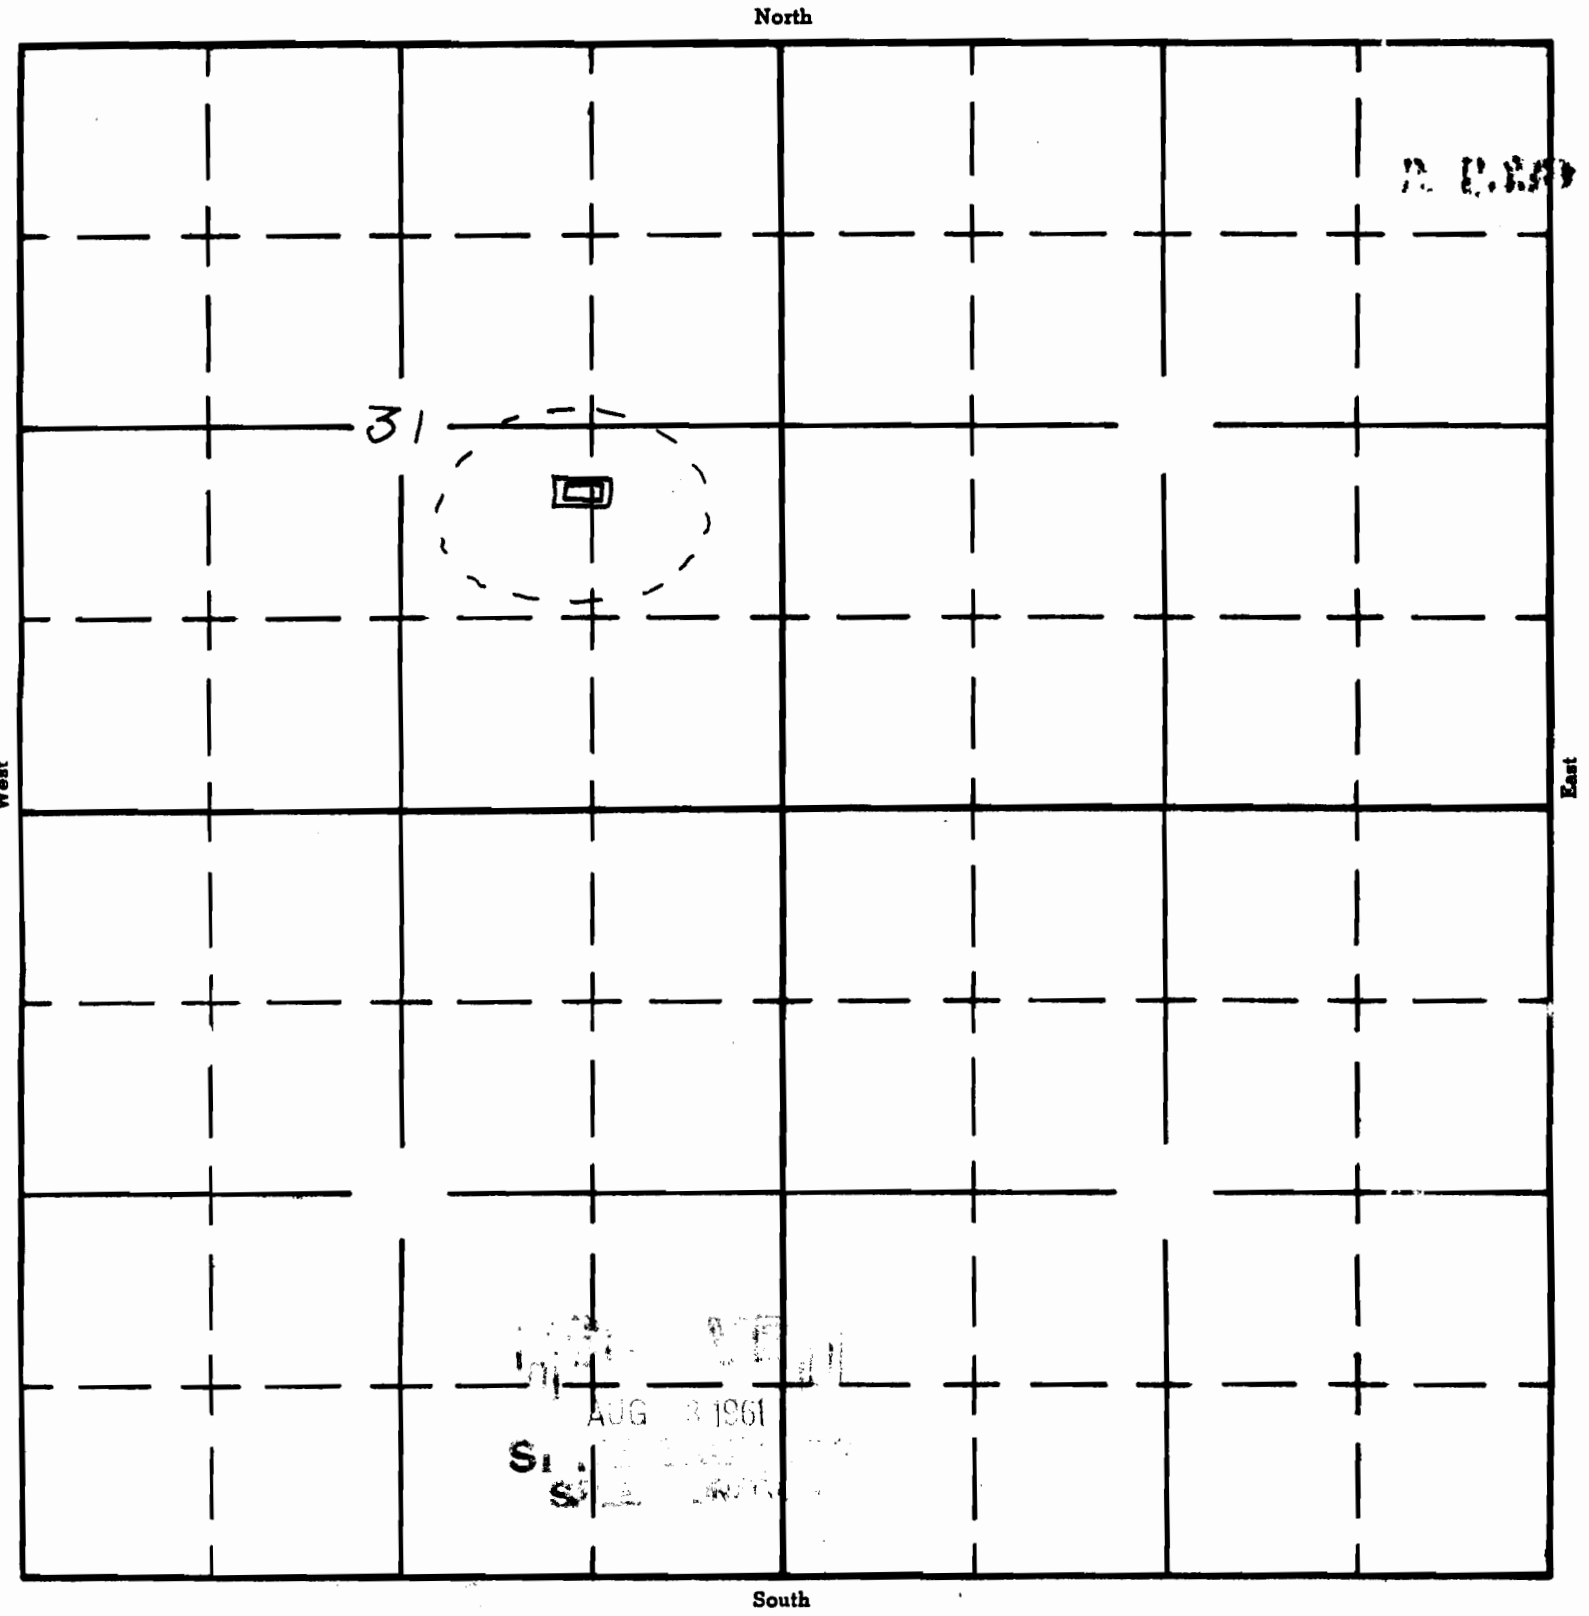

APPLICATION No. R-36083
PERMIT No. 11 0070