

Form AI-187
March 1961

UNITED STATES
DEPARTMENT OF THE INTERIOR
BUREAU OF LAND MANAGEMENT

SECTION


SW 1/4 NW 1/4

Oregon State Water Filings

12

TOWNSHIP 31 S, RANGE 32 1/2 W. M.

North

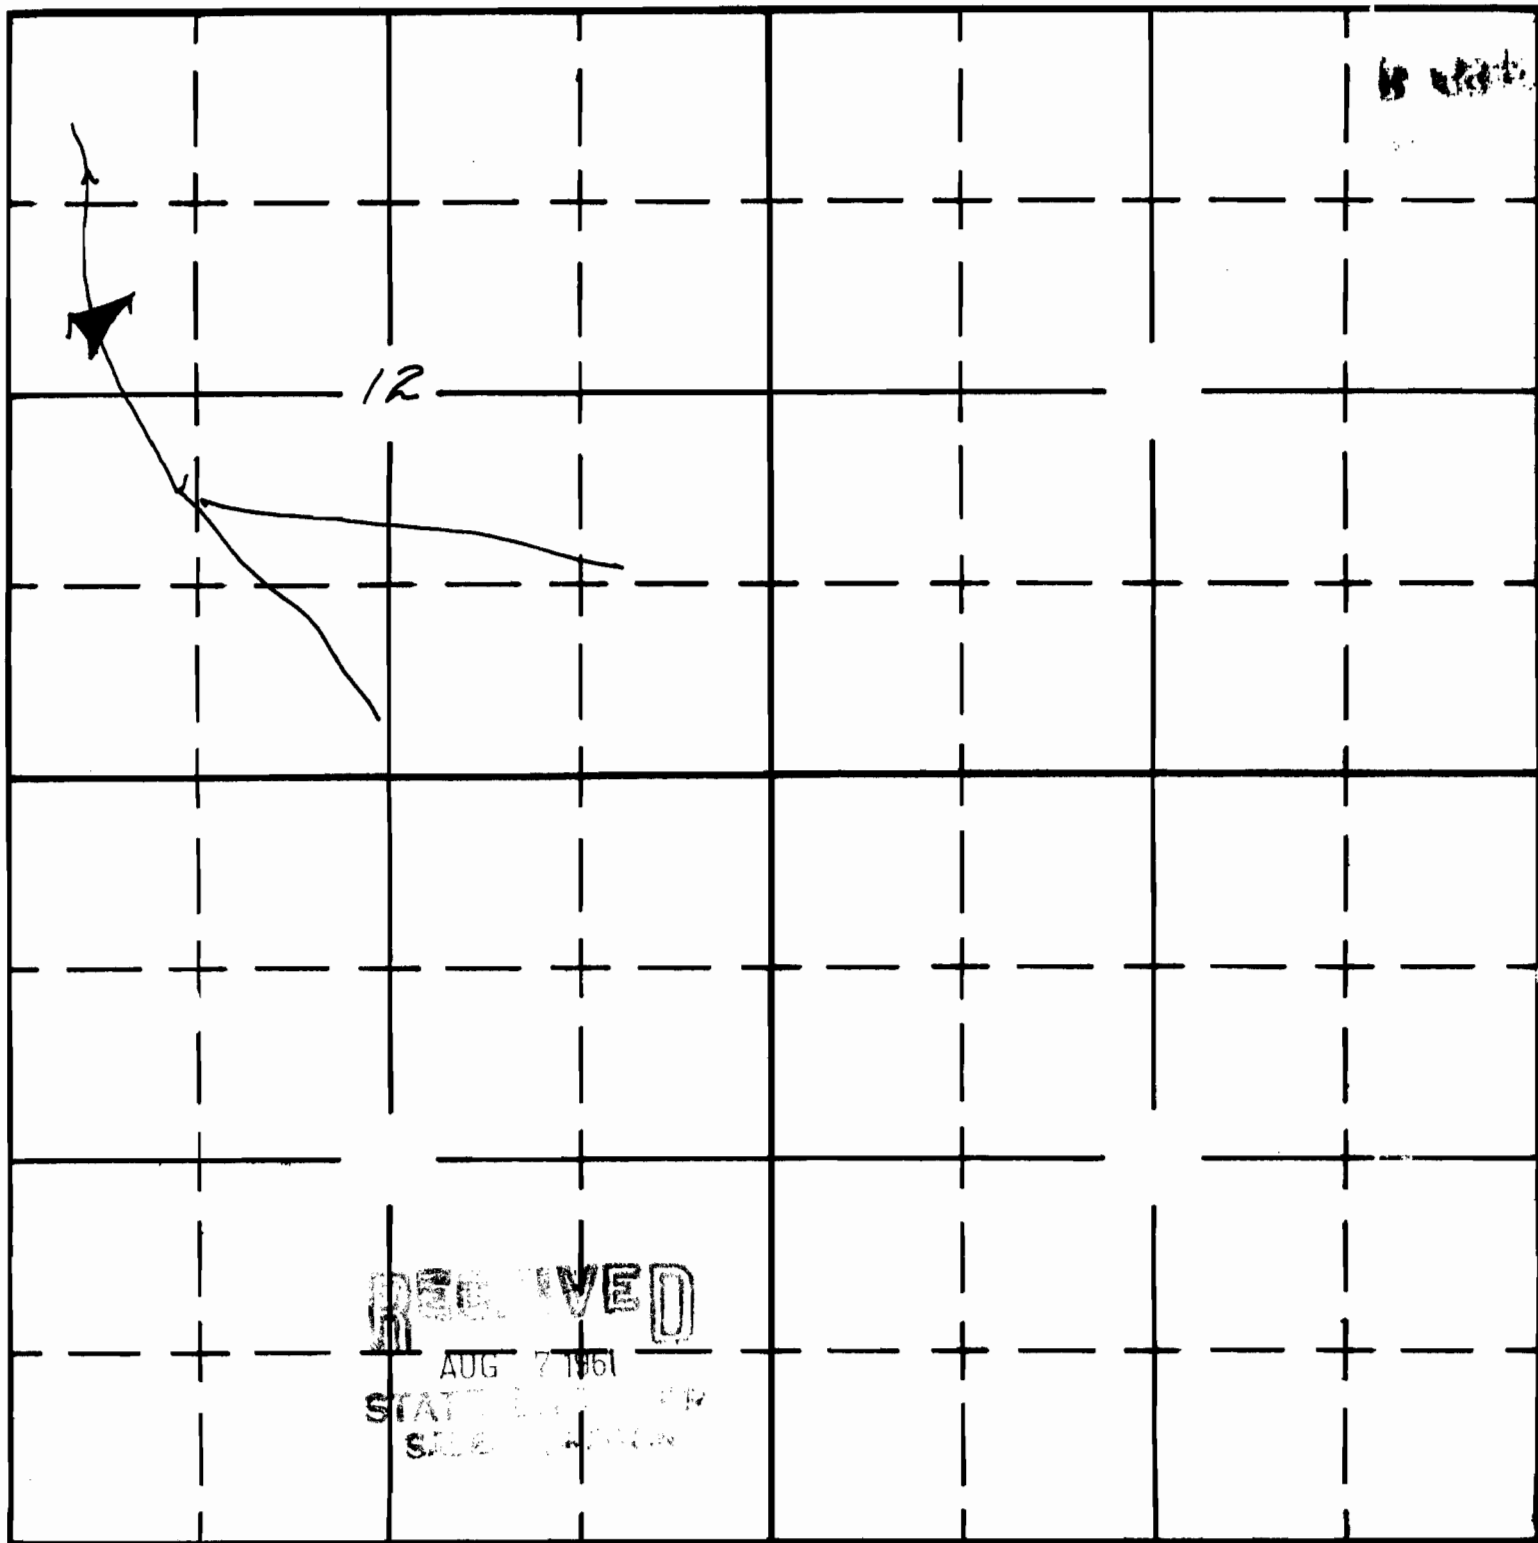

South

APPLICATION No. R-36116

PERMIT No. R 2949