




T. 4 S., R. 11 E., W.M.

N

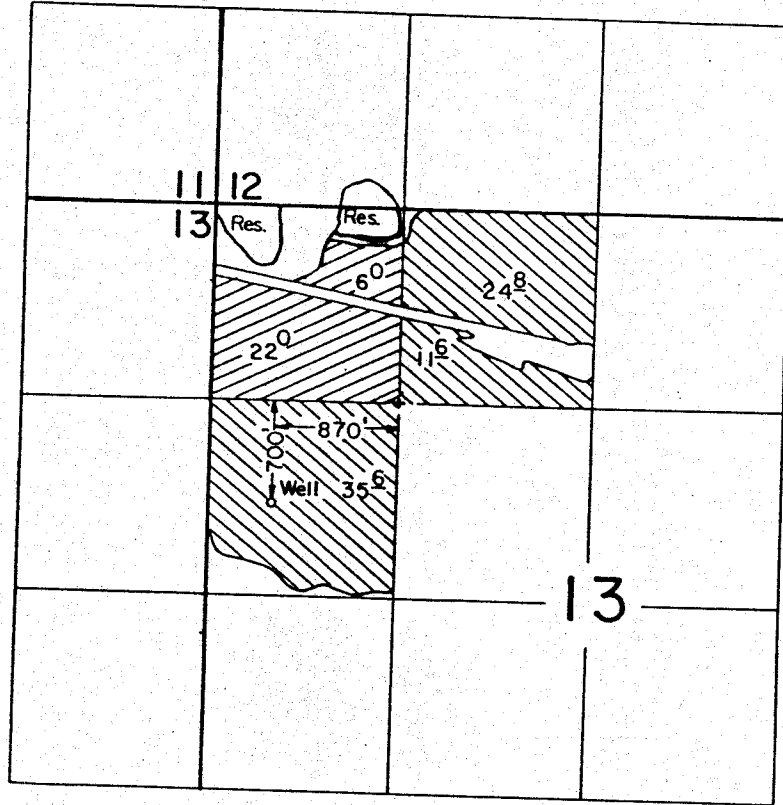

 PRIMARY
 SUPPLEMENTAL

Scale: 1" = 1320'

FINAL PROOF SURVEY
UNDER

Application No. G-5897, Permit No. G-5615.....

IN NAME OF

W. D. CODY

Surveyed April 13, 1988, by T. Warren

41065-379-5L
4/13/88 TMW