


# T.4S. R.11E. W.M.

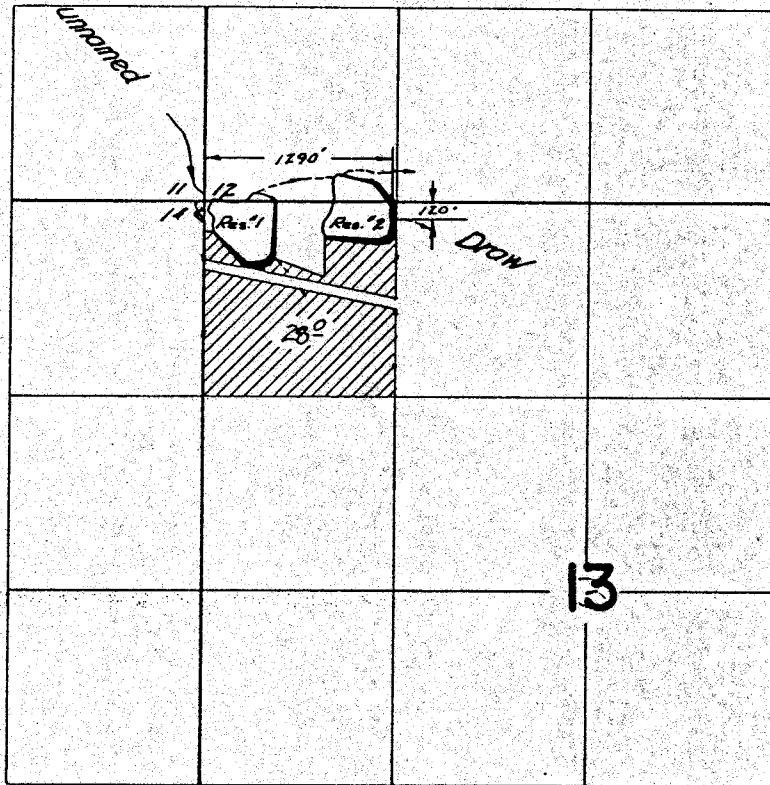

## FINAL PROOF SURVEY UNDER

Application No. <sup>39720</sup> ~~R. 38570~~ Permit No. <sup>29550</sup> ~~R. 3958~~  
IN NAME OF

..... W. J. CODY .....

Surveyed Nov. 15, 1967, by V. Garner.....