


T.4S. R.1E. W.M.

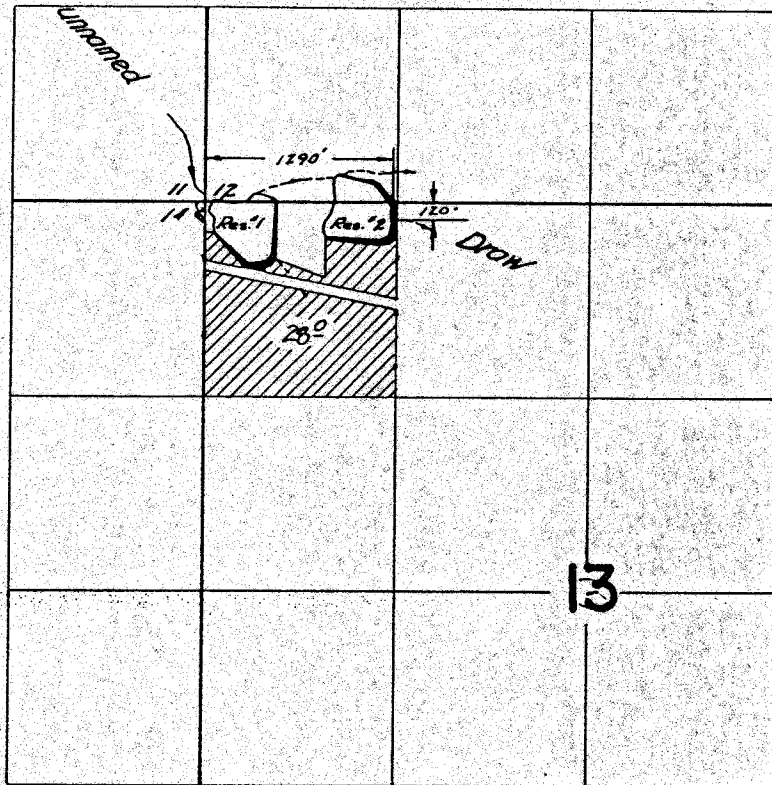

FINAL PROOF SURVEY UNDER

Application No. ³⁹⁷²⁰ ~~R. 38570~~ Permit No. ²⁹⁵⁵⁰ ~~R. 3958~~
IN NAME OF

..... W. J. CODY

Surveyed Nov. 15, 1967, by V. Garner.....