


T8S. R23E. WM.

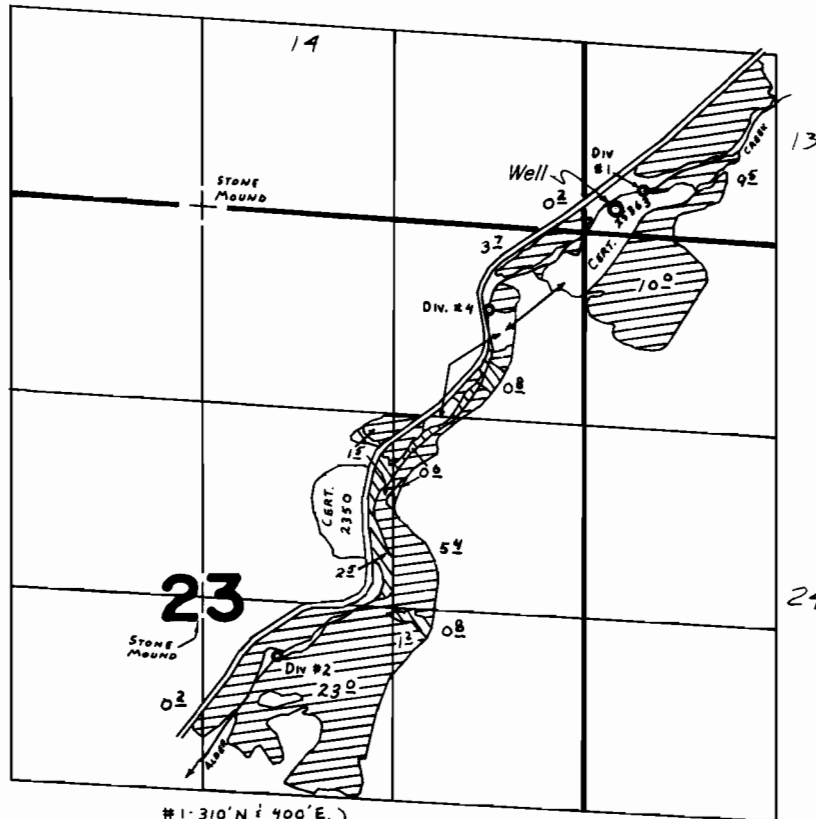

Div. Pts. Loc: #1-310° N. 400' E.
 #2-3060' S. 2100' W. } ALL FROM NE. COR. SEC. 23.
 #4-580' S. 650' W. }

▨ - APP. # 41229
 ▨ - APP. # 52798

Well Loc: 150' N. & 210' E from NE Corner Section 23

FINAL PROOF SURVEY UNDER

TRANSFER NO. 3469
 G-7426
 52798

G-6925
 39852 710
 30826 714

Application No. 41229 Permit No. 30826
 IN NAME OF

ARTHUR ROBISON

Surveyed AUG. 6 1974, by L. H. NUNN

JUNE 6 1975 L. TOLL
 AUG 25 1976 D. NORBY
 AUG. 14, 1979 *[Signature]*