T. 11 S., R. 2 W., W.M.

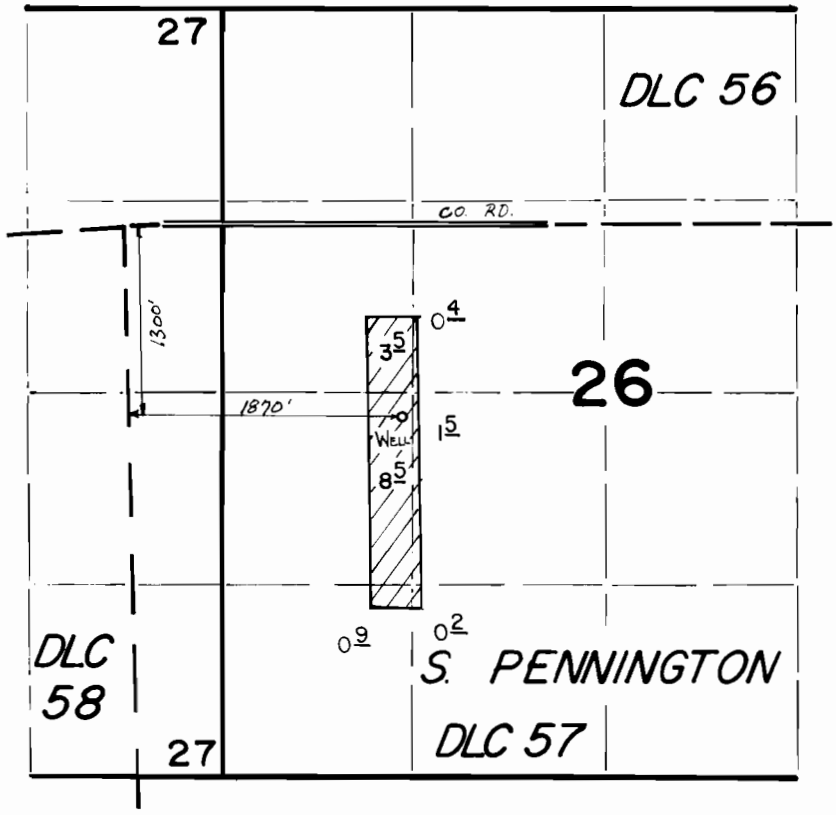

FINAL PROOF SURVEY
UNDER

Application No. G8544 Permit No. G 7940

IN NAME OF

DUANE & RUBY D. HARTMAN

Surveyed OCT. 19, 1983, by M. CAHILL

DFM-3LL-73 mc