


T. 39 & 40 S., R. 8 W., W. M.

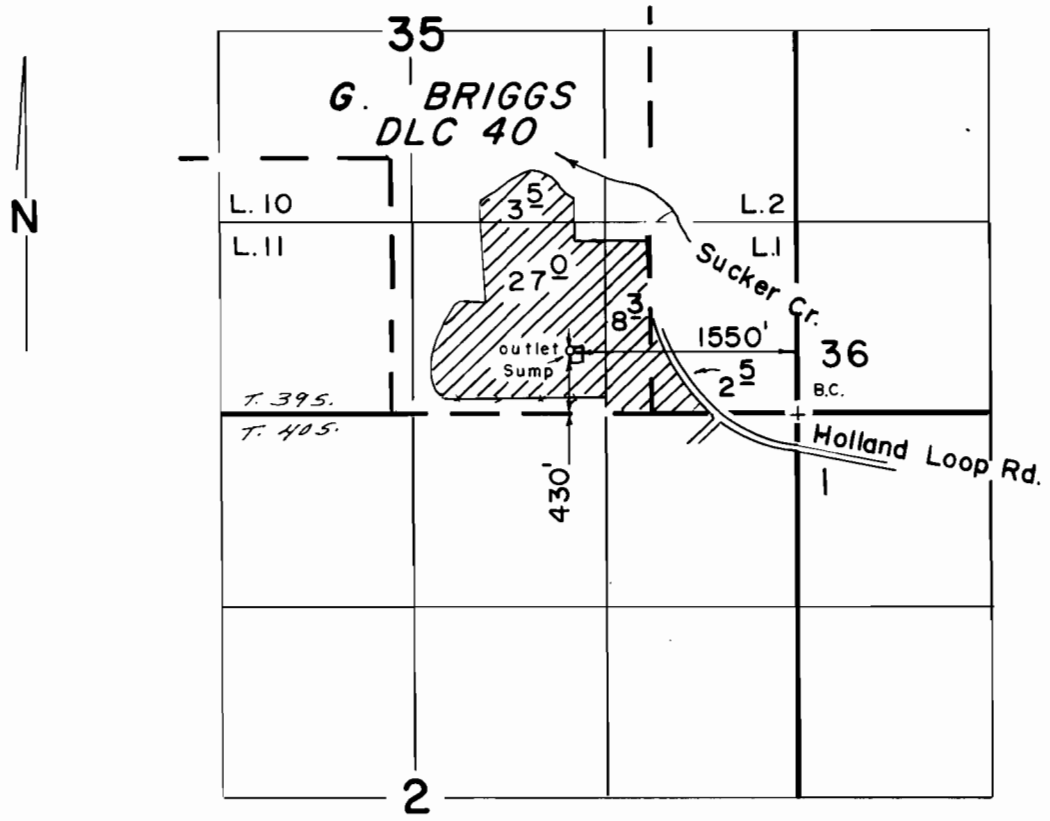

Scale: 1" = 1320'

FINAL PROOF SURVEY UNDER

Application No. ~~G. 8998~~ Permit No. G. 8434
IN NAME OF

GEORGIA L. TREFETHEN

Surveyed MAY 15, 1986, by B. S. JAMES.