


# T. 1 S., R. 9 W., W. M.

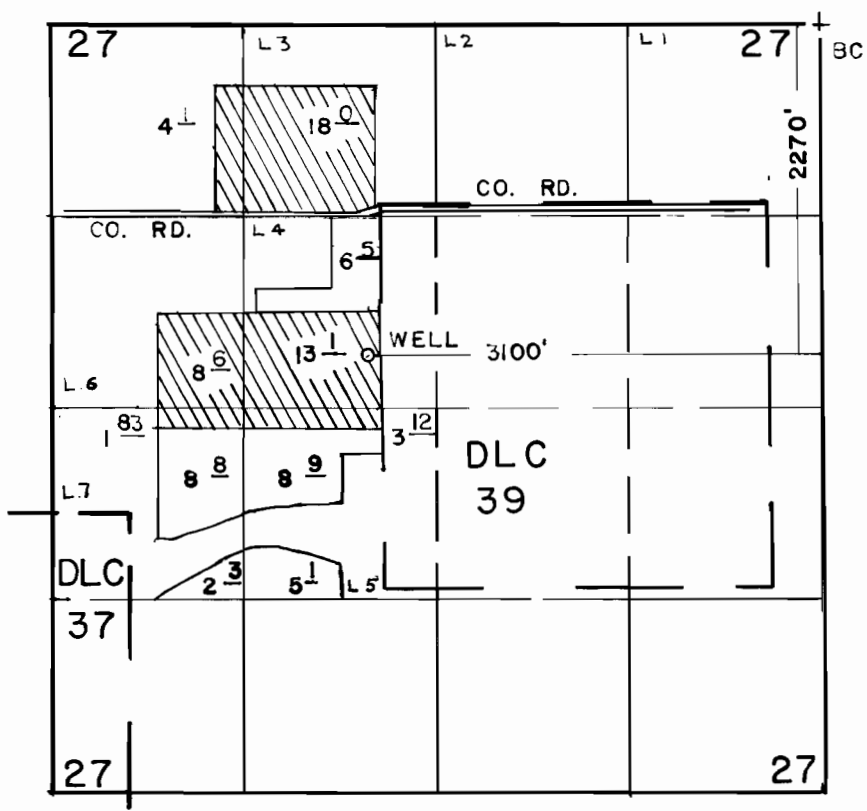

## FINAL PROOF SURVEY UNDER

Application No. G.9128.. Permit No. G.8489.....  
IN NAME OF

...EDWARD E. MYERS.....

Surveyed JUN 11 1984, by P. PAGTER.....