
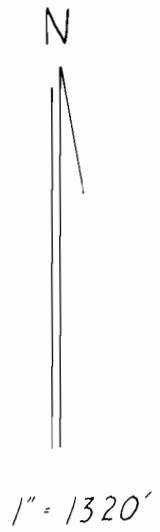


# T. 14S., R. 4 & 5 W., W.M.

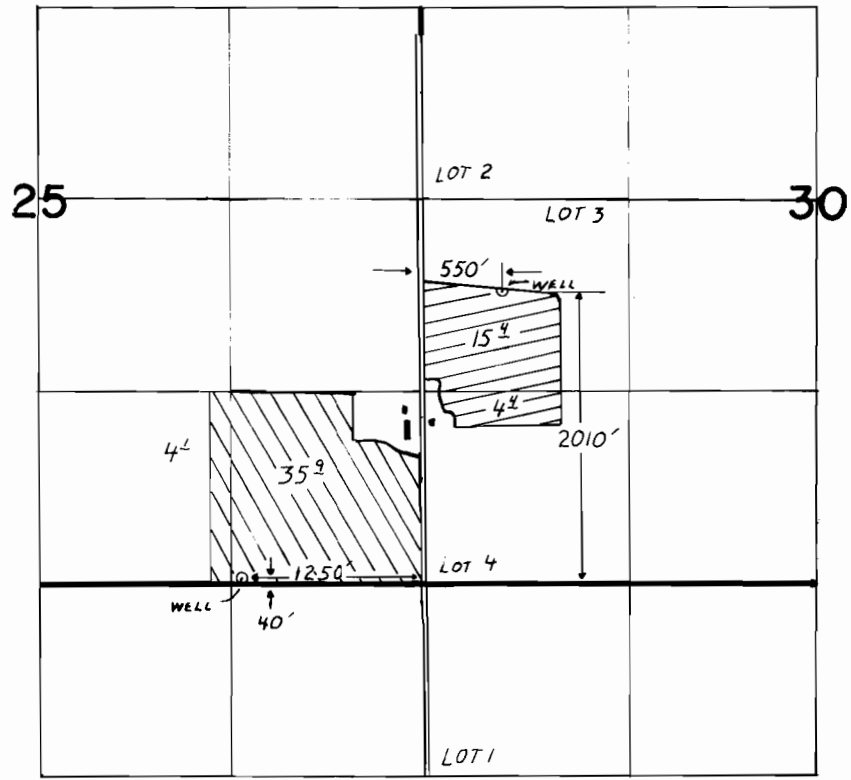

## FINAL PROOF SURVEY UNDER

Application No. **G9532** Permit No. **G9214**  
**G9533** **G8942** 

IN NAME OF  
**CHESTER LEE CROWSON**

Surveyed **Nov. 25, 1987**, by **T.M. Warren**