





T. 7S., R. 1W., W.M.

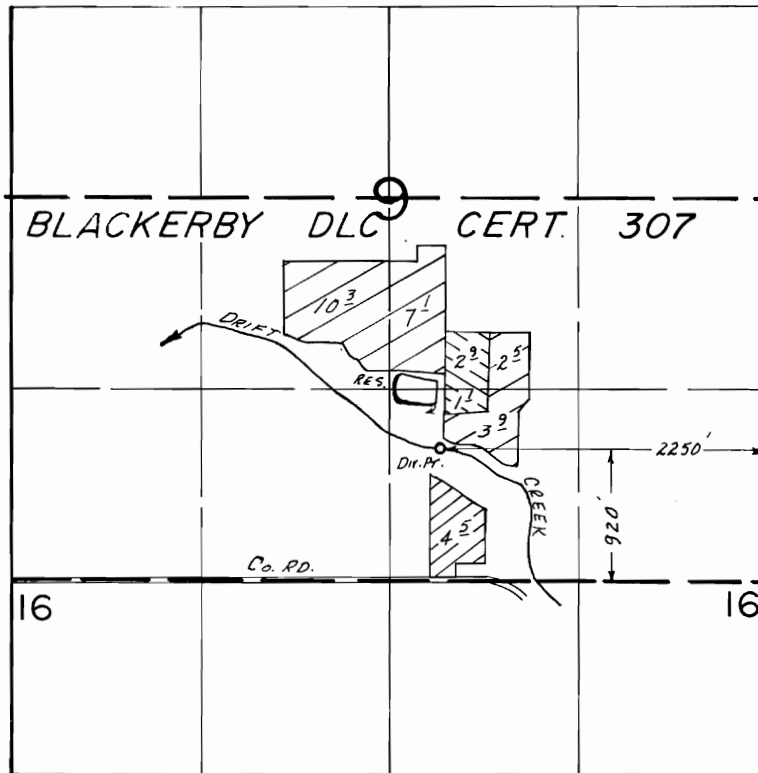

SCALE: 1"=1320'

-  Transfer No. 3975
 -  Primary
 -  Supplemental
- } Permit 42496

FINAL PROOF SURVEY UNDER

Transfer No. 3975
 R-53292 R-6736
 Application No. 53293 Permit No. 42496.....
 IN NAME OF

.....JEROME GEHRING.....

Surveyed Oct. 4..... 1984, by B.W. BISHOP.....