


P-42853 60354
R-7024 60353

T.2 S., R.17 E., W.M.

SCALE: 1"=1320'

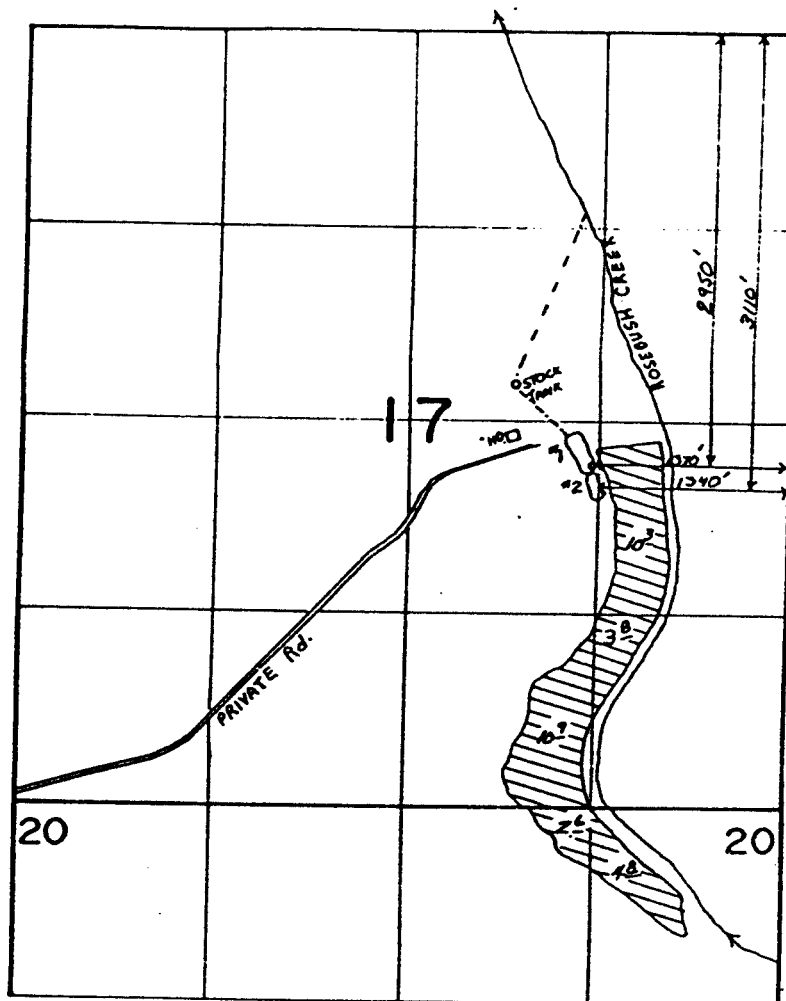

FINAL PROOF SURVEY
UNDER

R-54647 R-7024
Application No. 54295 Permit No. 42853
IN NAME OF

MYRTLE BARNUM

Surveyed MAY 7, 1985, by V.L. CHURCH