
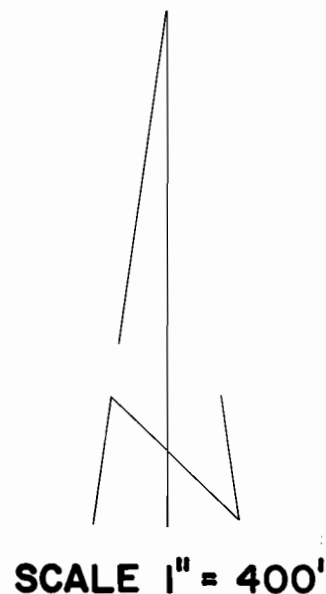


T. 24S., R. 34E., W. M.

SW1/4 SE1/4 SEC. 19

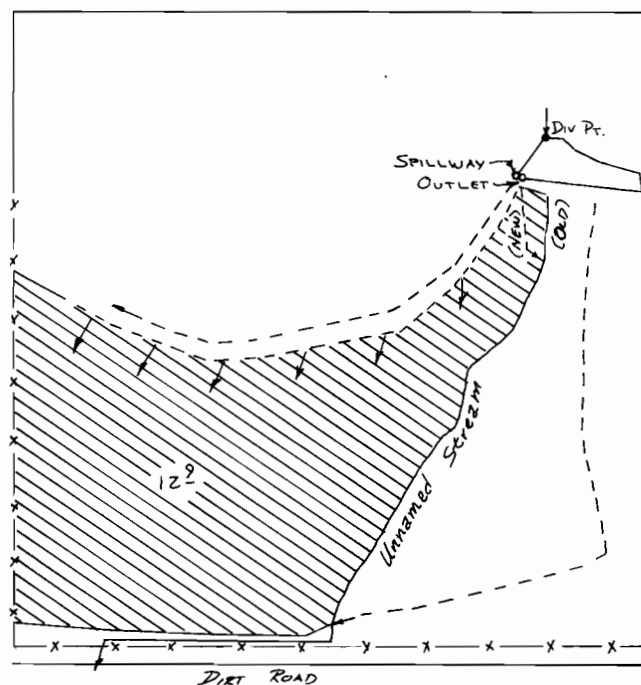

Div. Pt. Loc: 1060' N. & 1110' E. FROM S $\frac{1}{4}$ COR. SECTION 19

FINAL PROOF SURVEY
UNDER

R-67714

R-10199

Application No. **67715** Permit No. **49172**
IN NAME OF

CLARENCE L. PHILLIS

Surveyed 7-30-1987, by V.L. Church